




T. 18 & 19 S., R. 1 W., W.M.

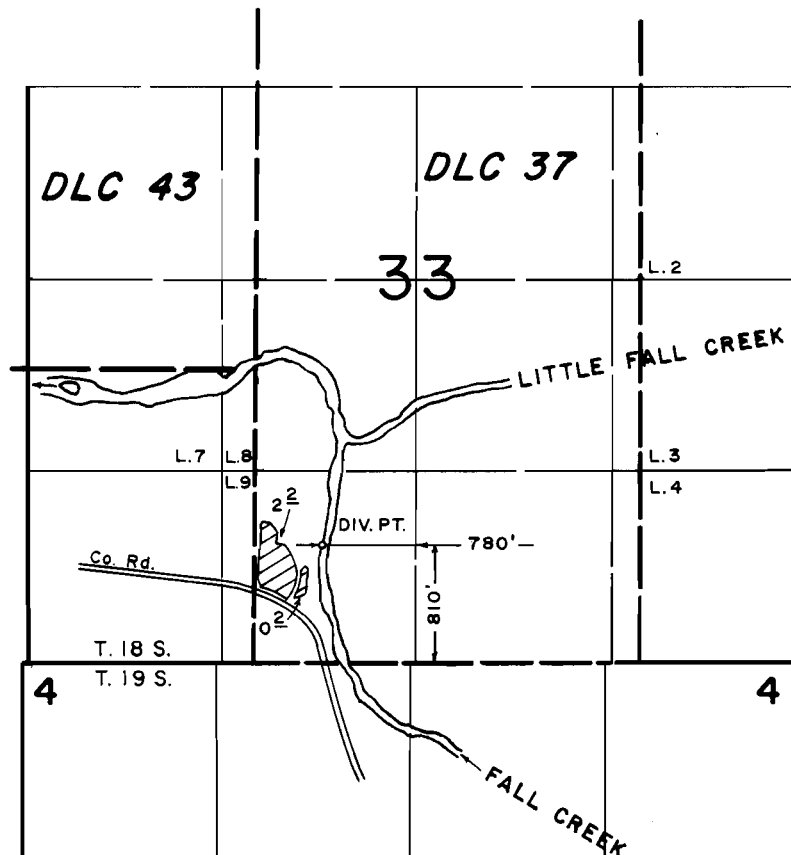

SCALE: 1" = 1320'

FINAL PROOF SURVEY UNDER

Application No. ~~63063~~ Permit No. ~~46330~~....
IN NAME OF

THOMAS P. MARMARO

Surveyed JUNE 13 1990, by T. M. WARREN