


T. 36 S., R. 5 & 6 W., W. M.

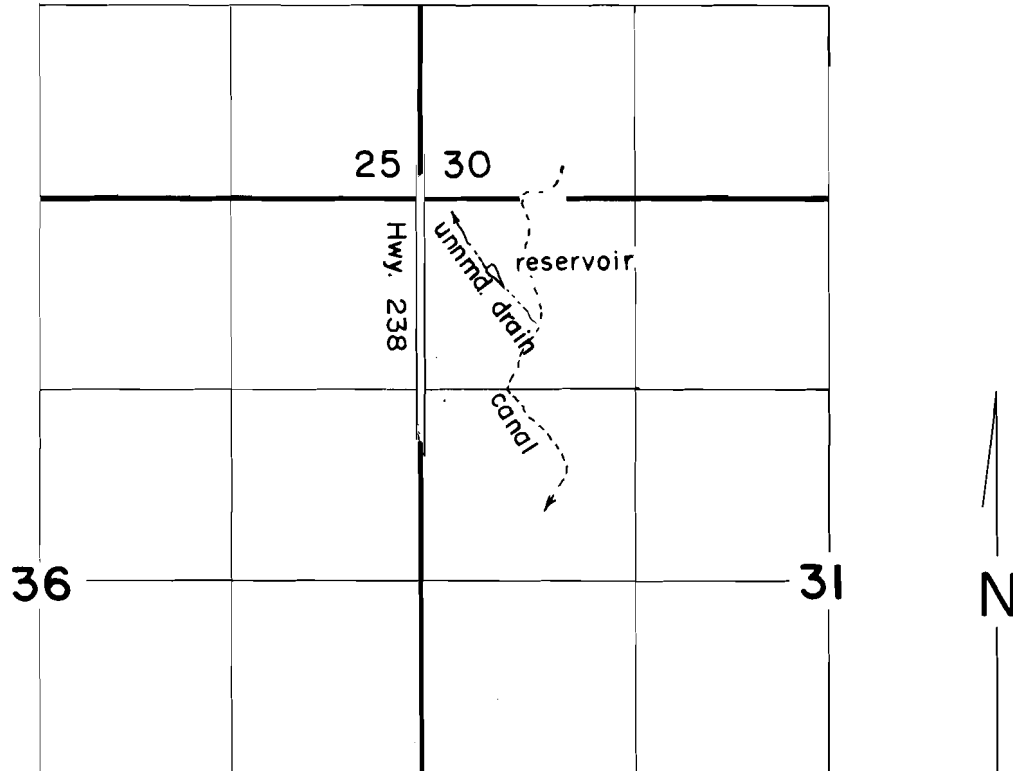

Scale: 1" = 1320'

FINAL PROOF SURVEY
UNDER

Application No. ~~R-63696~~ Permit No. ~~R-8523~~
IN NAME OF

GLEN F. RICHARDSON

Surveyed AUG. 25, 1988, by B. S. JAMES