


T.30S, R.5W, W. M.

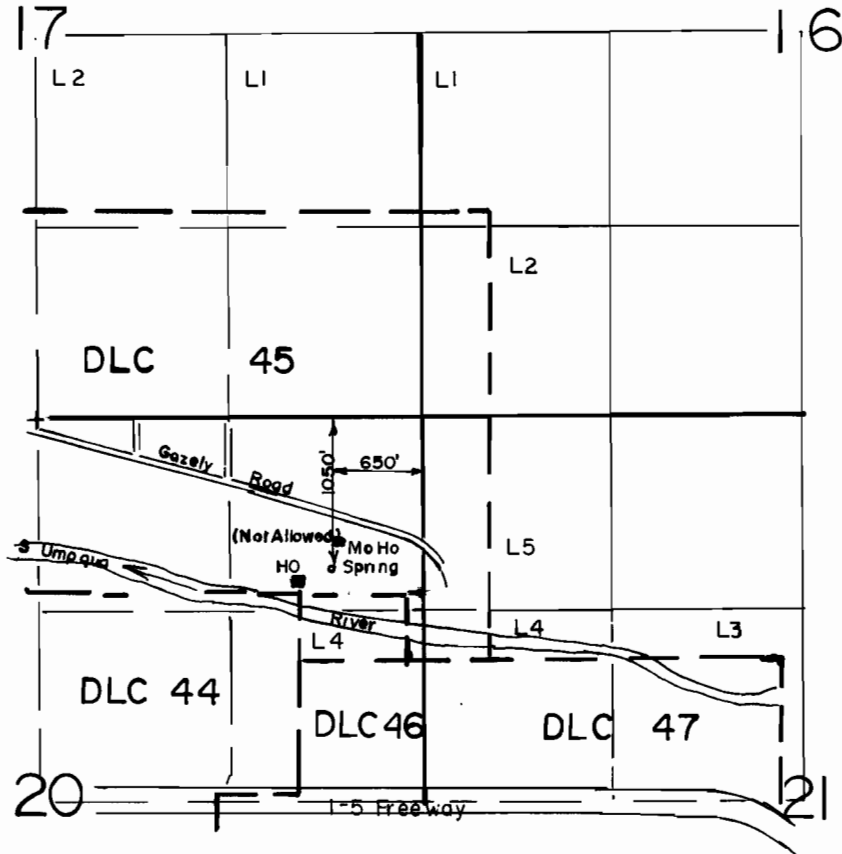

SCALE: 1"=1320'

**FINAL PROOF SURVEY
UNDER**

Application No. 65161.. Permit No. 47647.....
IN NAME OF

..... MARY SANDERS

Surveyed MAY 4... 1990., by B.S. JAMES.....