




T. 34 & 35 S., R. 1 E., W.M.

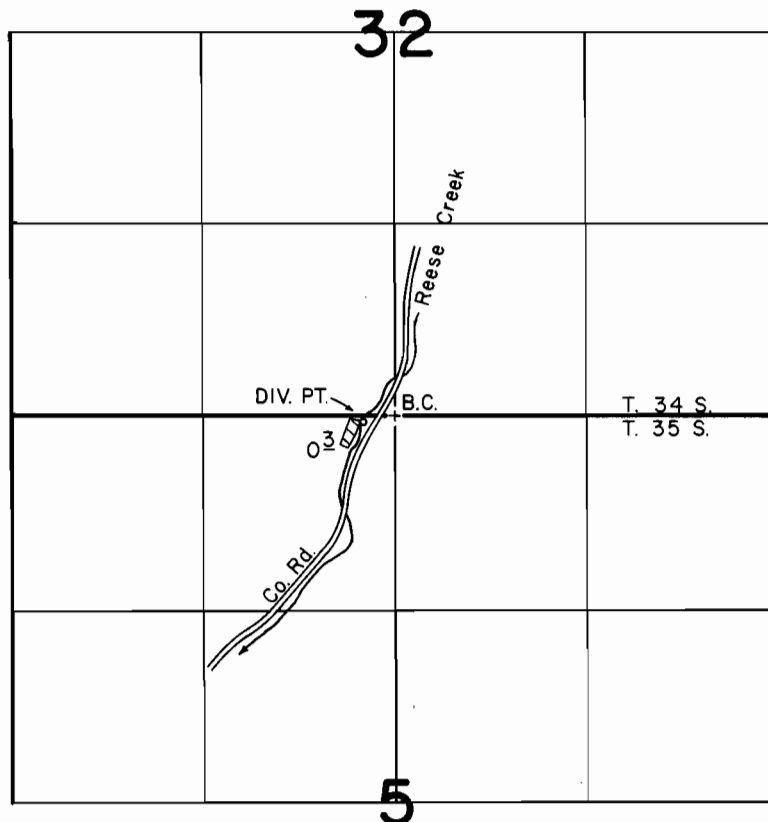

DIV. PT. LOC.: 40' S. & 230' W. FROM N. 1/4 CORNER SECTION 5.

SCALE: 1" = 1320'

FINAL PROOF SURVEY UNDER

Application No. 65220 Permit No. 48429
IN NAME OF

DWANE E. &/OR COLEENE I. TEJCKA

Surveyed MARCH 1, 1990, by B. S. JAMES