


T.39S., R.7W., W. M.

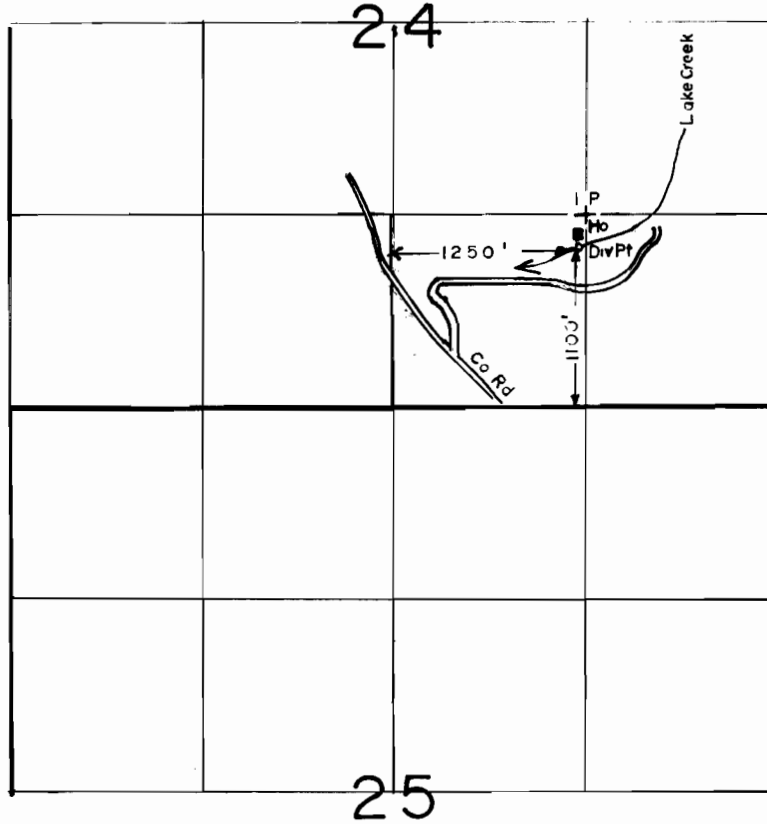

SCALE: 1" = 132 0'

FINAL PROOF SURVEY
UNDER

Application No. 65233.. Permit No. 47662.....
IN NAME OF

ERNEST S. & LOUELLA P. BIERI.....

Surveyed MAY. 24. 19.90, by .B.S. JAMES.....