




T. 41 S., R. 8 W., W.M.

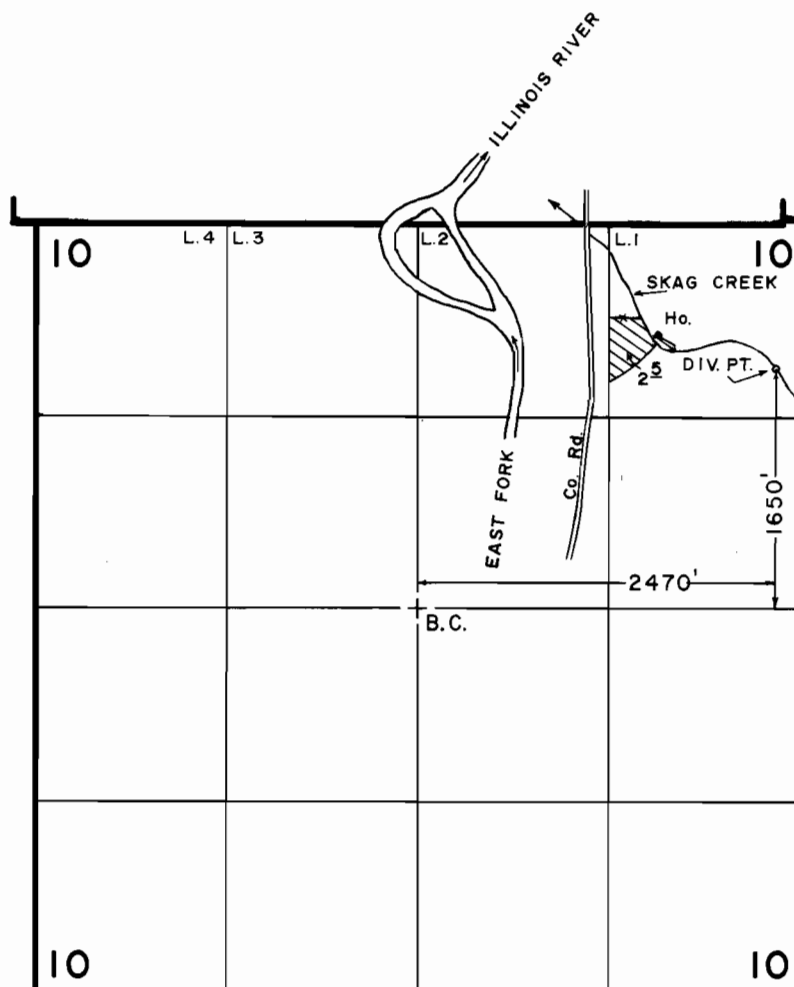

SCALE: 1" = 1320'

FINAL PROOF SURVEY UNDER

Application No. 65968. Permit No. 48028....
IN NAME OF

.....DAVID KENDALL.....

Surveyed MAY.22. 1990, by B.S. JAMES...