
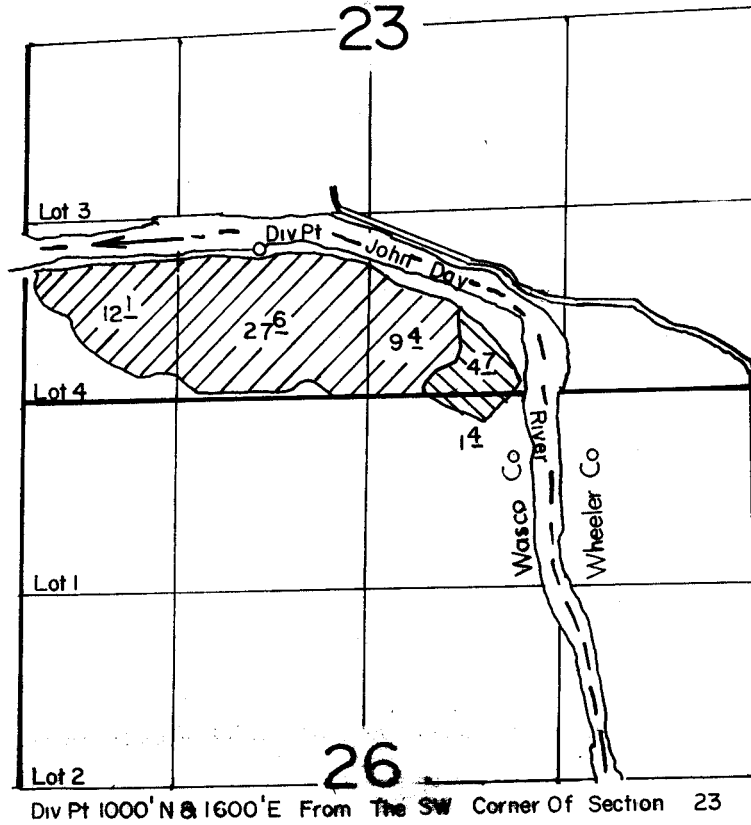


P.41913  
65295  
65327

T.8S., R.19E., W.M.

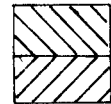

SCALE: 1"=1230'

 Permit 49235  
Permit 41913

**FINAL PROOF SURVEY  
UNDER**

55878

41913

Application No. 68110... Permit No. 49235.....  
IN NAME OF

Connecticut General Life Insurance Co...

Surveyed MAY. 16. 1990., by R.W. BISHOP.....