


T.30S., R.14W., W.M.

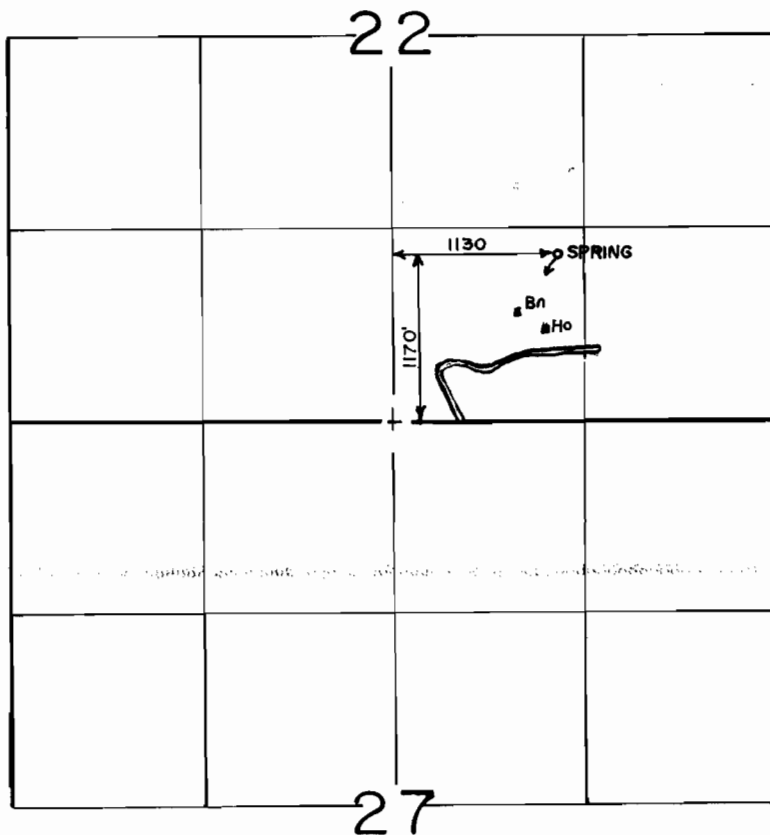

SCALE: 1"=1320'

FINAL PROOF SURVEY
UNDER

Application No. 6.8.140.. Permit No. 48833.....
IN NAME OF

.....H. DAVID..... LONDAGIN.....

Surveyed JUNE 5... 1990., by B.S. JAMES.....