


T.39S., R.8W., W.M.

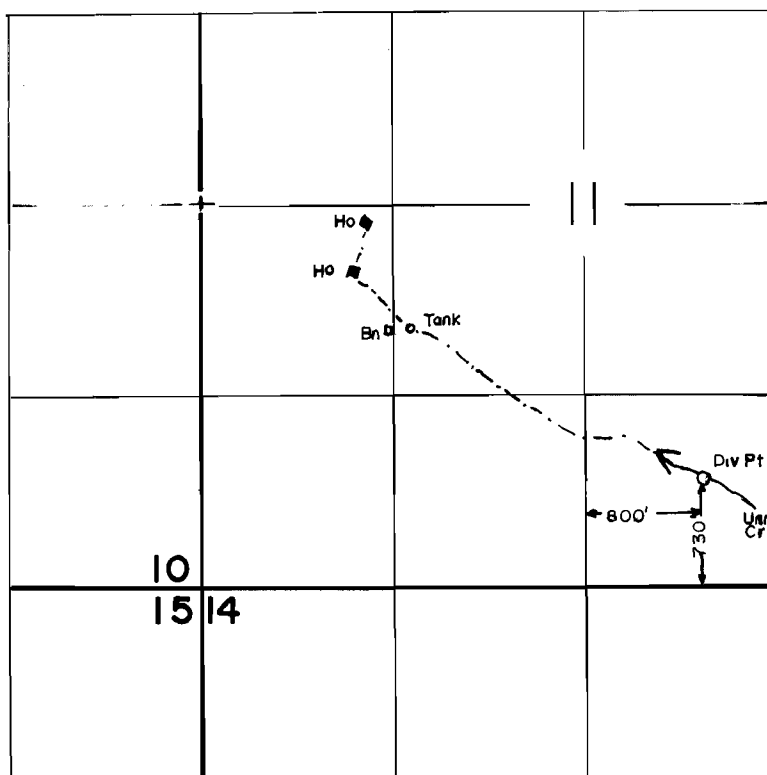

SCALE: 1" = 1320'

FINAL PROOF SURVEY
UNDER

Application No. 68256.. Permit No. 49269.....
IN NAME OF

.....THOMAS.....K.....EMONDS.....

Surveyed MAY..29. 1990., by B.S.JAMES.....