


T.30S., R.5W., W.M.

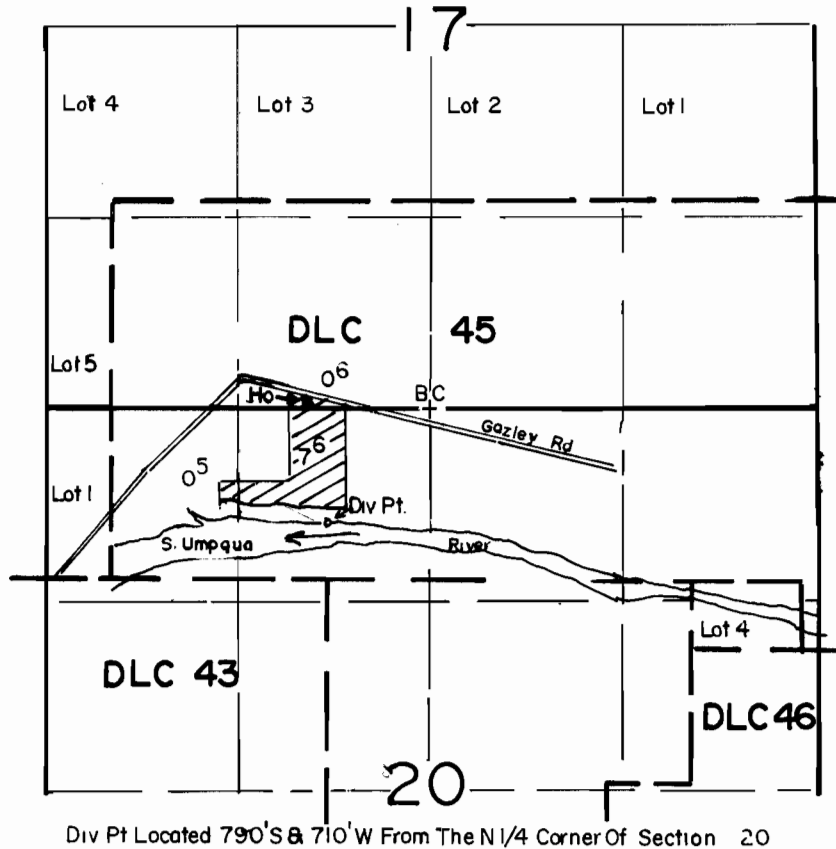

SCALE:1"=1320'

**FINAL PROOF SURVEY**  
UNDER

Application No. 68,265.... Permit No. 4,9244.....  
IN NAME OF

.....GEORGE..M...HEATH.....

Surveyed APRIL 4... 1990., by B.S.JAMES.....