


T.4S., R.38E., W.M

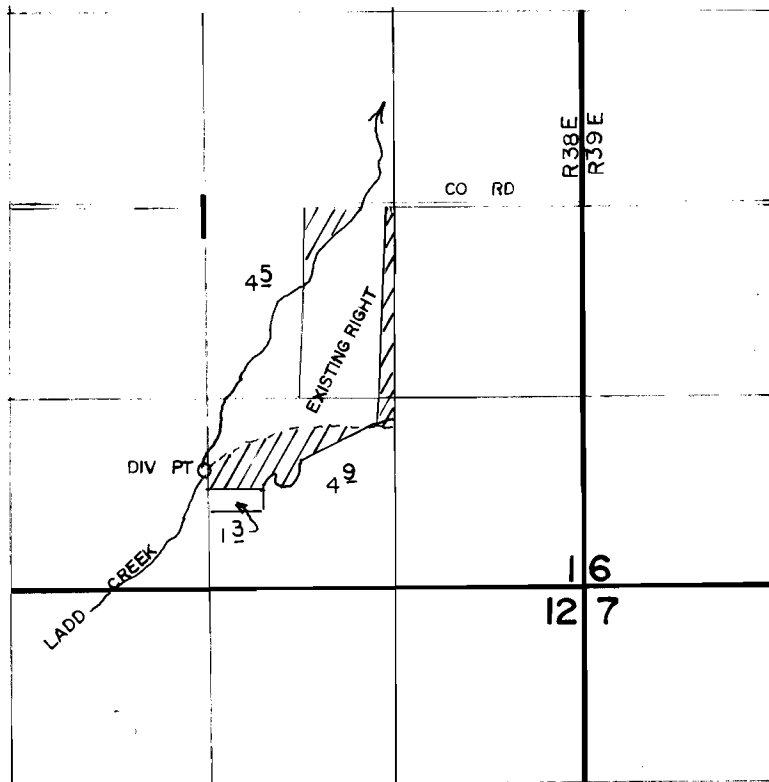

DIV PT LOCATED 1800' S & 50' W FROM C1/4 OF SECTION 1

SCALE: 1"=1320'

**FINAL PROOF SURVEY
UNDER**

Application No. 68325... Permit No. 49483.....
IN NAME OF

Glavis A., Evalee N. & Lorna Reed.....

Surveyed JUNE 14, 1990., by H.B. HADDEN.....