


T. 29 S., R. 5 W., W.M.

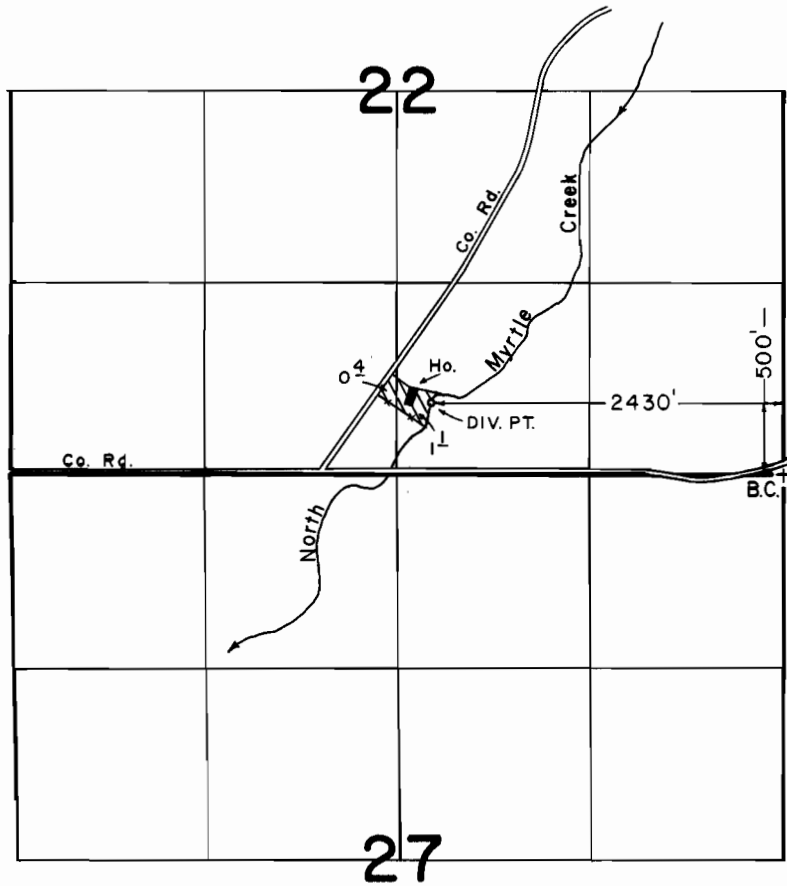

SCALE: 1" = 1320'

**FINAL PROOF SURVEY**  
UNDER

Application No. 68472.. Permit No. 49447.....  
IN NAME OF

.....LEONA RUTH MARTIN.....

Surveyed MARCH 14 1990, by ..B. S. JAMES....