




T. 29 S., R. 4 W., W.M.

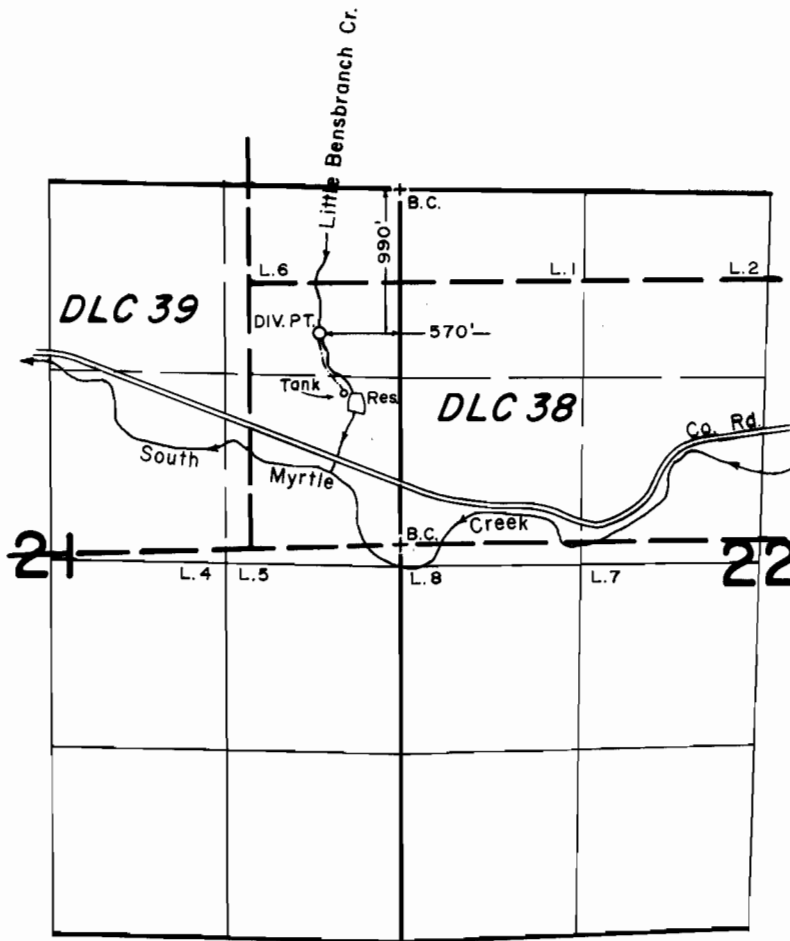

SCALE: 1" = 1320'

FINAL PROOF SURVEY
UNDER

Application No. 68559.. Permit No. 49590.....
IN NAME OF

DANIEL SNYDER

Surveyed MARCH 15 1990, by B. S. JAMES.....