


T. 35 S., R. 1 W., W.M.

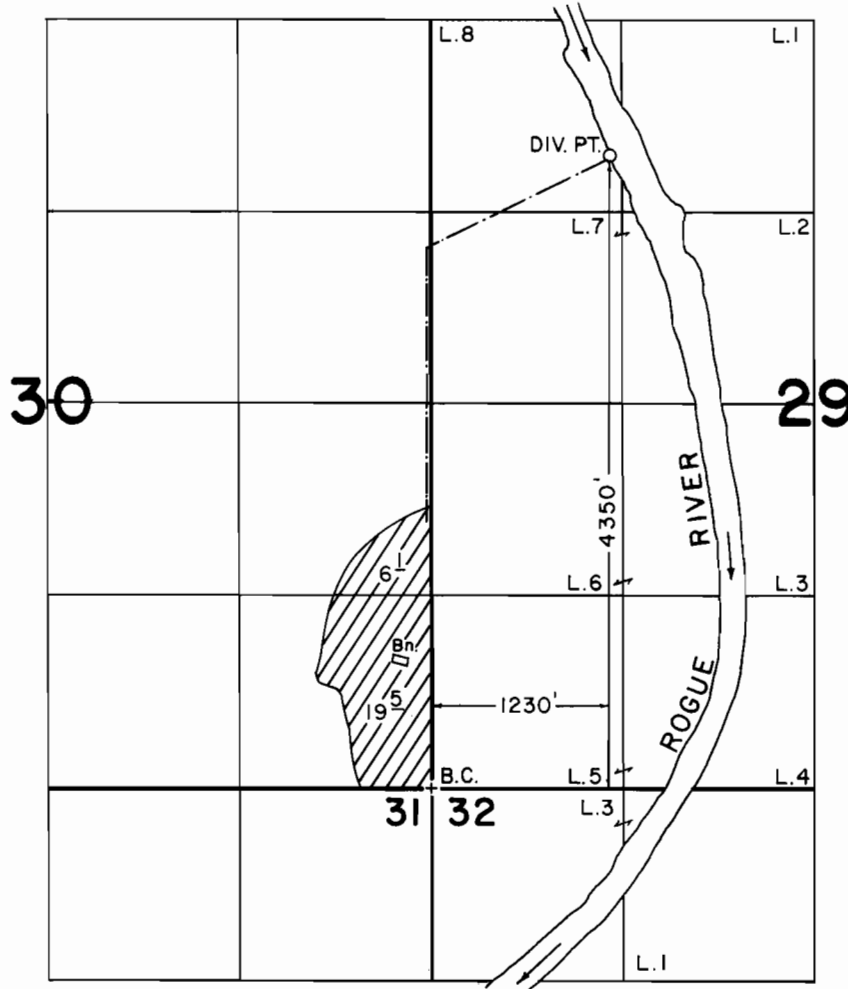

SCALE: 1" = 1320'

FINAL PROOF SURVEY
UNDER

Application No. 68658.. Permit No. 49607....
IN NAME OF

WILLIAM E. & ALMA J. SPICER

Surveyed MARCH 8 1990., by ..B. S. JAMES.....