




T. 29 S., R. 4 W., W.M.

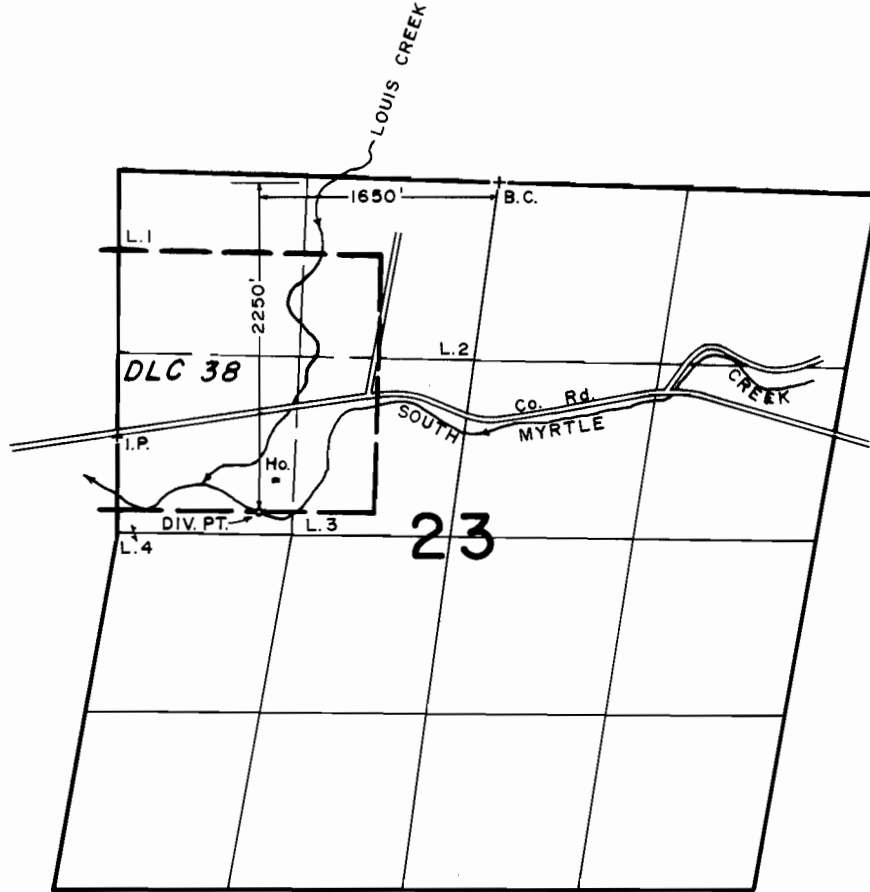

SCALE: 1" = 1320'

**FINAL PROOF SURVEY**  
UNDER

Application No. 68668.. Permit No. 49687.....  
IN NAME OF

.....**RAYMOND H. MOOR**.....

Surveyed MARCH 14 1990, by B. S. JAMES.....