


T.39S., R.7W., W.M.

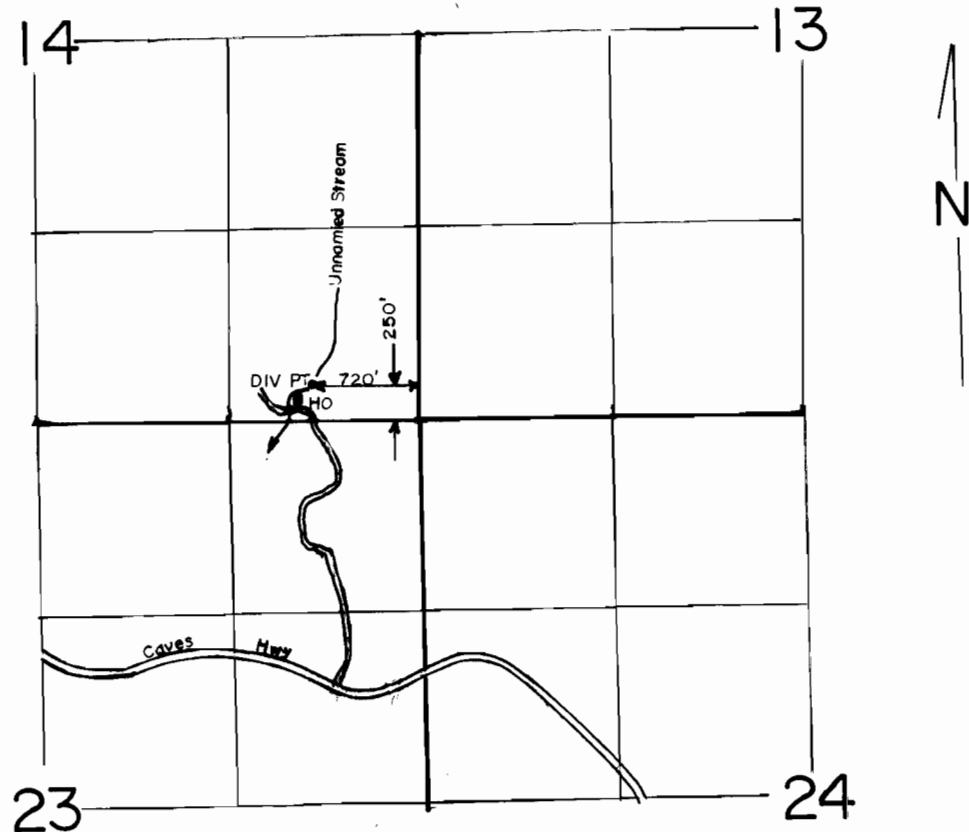

SCALE: 1"=1320'

FINAL PROOF SURVEY
UNDER

Application No. 68803.. Permit No. 49902.....
IN NAME OF

.....JOHN W PRUETT.....

Surveyed MAY.24. 1990., by B.S.JAMES.....