




# T. 16 S., R. 18 E., W.M.

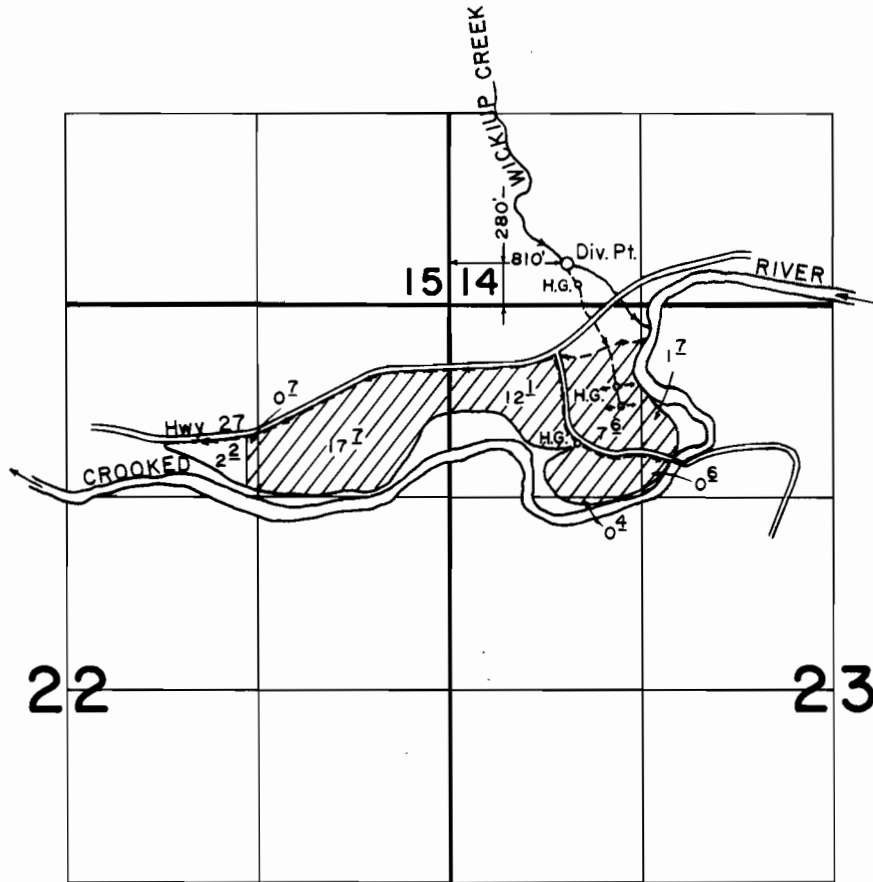

SCALE: 1" = 1320'

## FINAL PROOF SURVEY UNDER

Application No. 68812... Permit No. 49905...  
IN NAME OF

**RICHARD E. PICKETT**

Surveyed JAN. 5... 1990, by B. W. BISHOP...