




T. 35 & 36 S., R. 2 W., W.M.

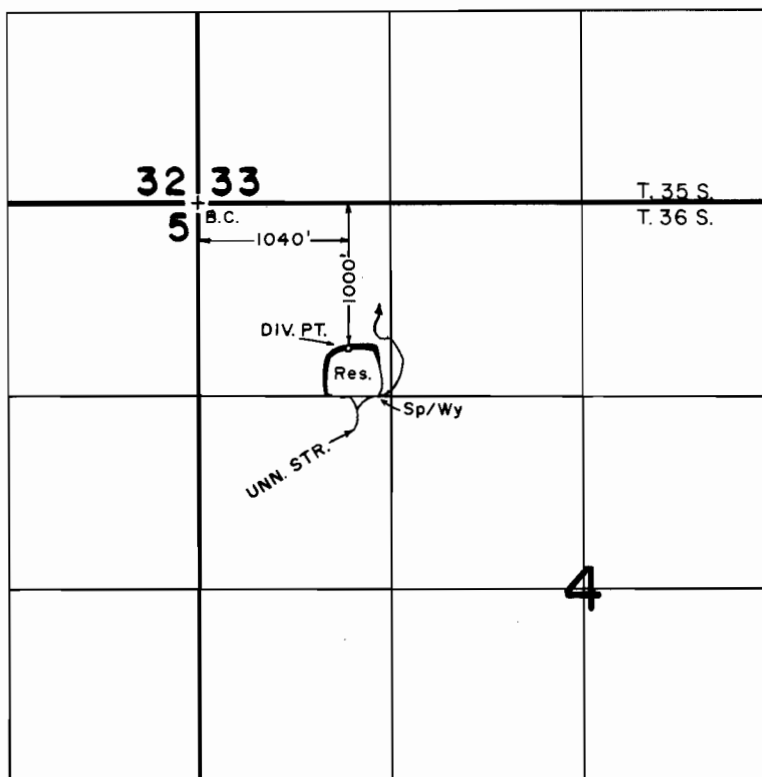

SCALE: 1" = 1320'

FINAL PROOF SURVEY
UNDER

Application No. R-68814 Permit No. R-10819...
IN NAME OF

PETE TOPOLIC & TOMISLAU DARDIE

Surveyed FEB. 26. 1990, by B. S. JAMES....