




T. 29 S., R. 5 W., W.M.

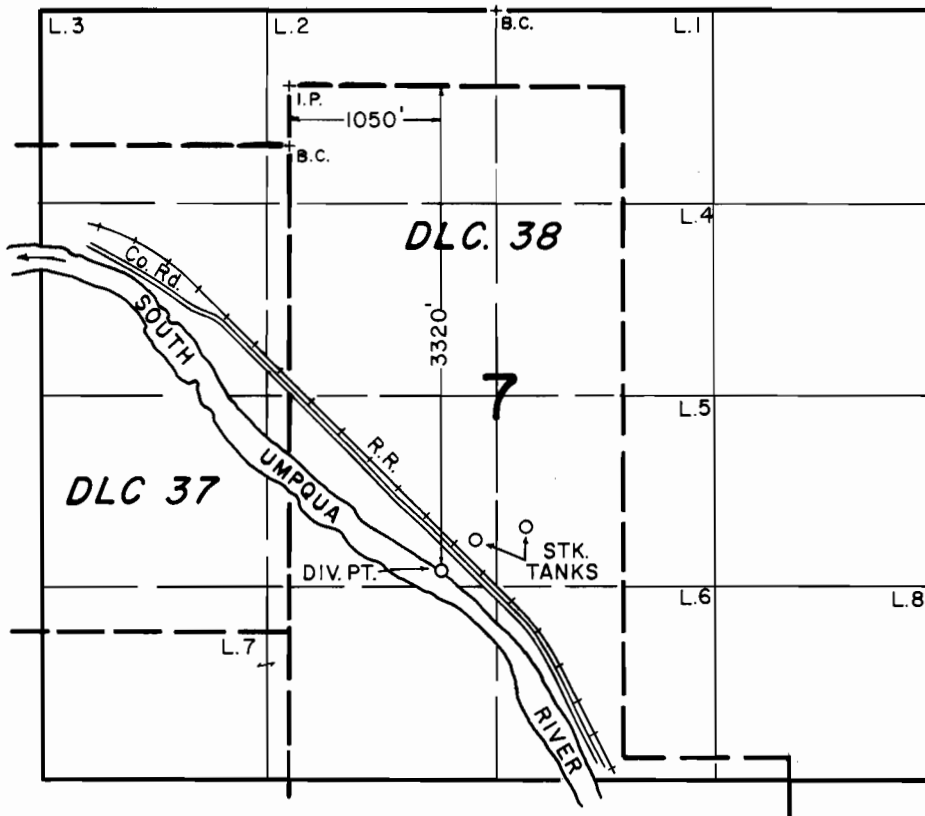

SCALE: 1" = 1320'

**FINAL PROOF SURVEY**  
UNDER

Application No. 68833... Permit No. 49907.....  
IN NAME OF

**JAMES BROCKMAN & MARJORIE WARD**

Surveyed MARCH 15 1990., by B.S. JAMES.....