
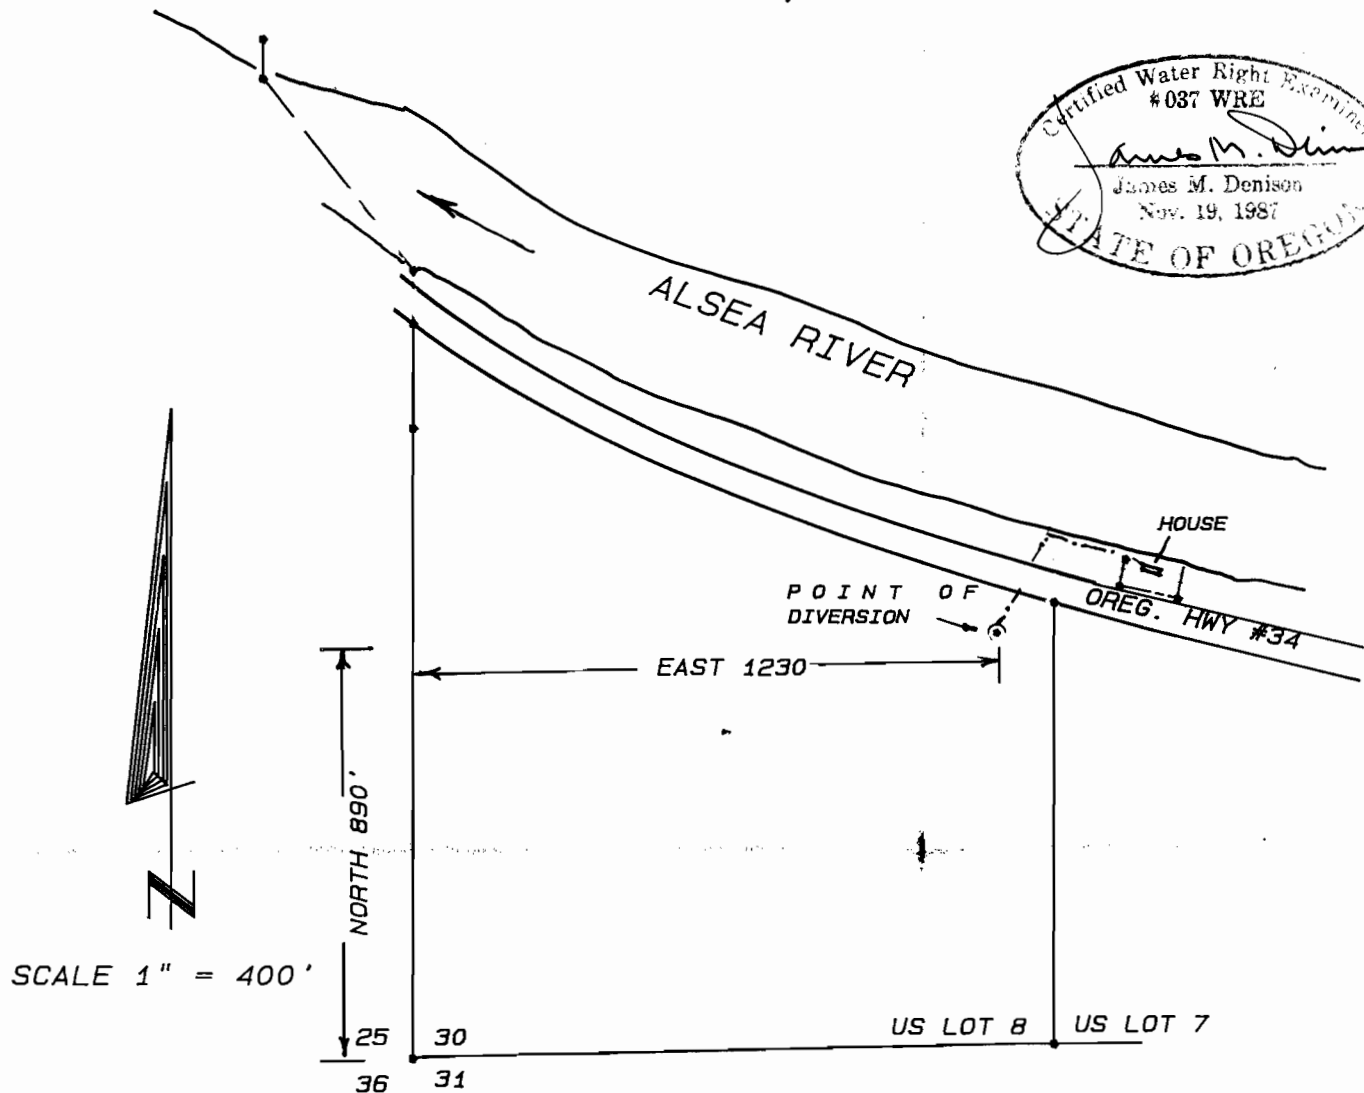


T. 13 S., R. 10 W., W. M.
US LOTS 7 & 8 IN SW 1/4, SEC. 30
LINCOLN COUNTY, OREGON

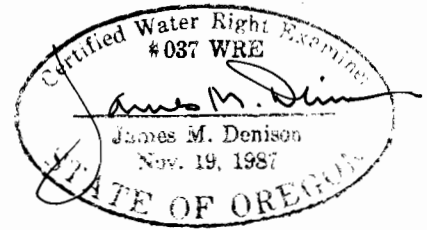

FINAL PROOF SURVEY
UNDER

APPLICATION NO. 69608, PERMIT NO. 50451

IN THE NAME OF DENNIE YOST

SURVEYED JANUARY 21, 1990 BY James M. Denison

This map is prepared solely for the purpose of showing location of a water right, and is not intended for use to provide dimensions of property ownership lines.