

FINAL PROOF SURVEY MAP
IN THE NAME OF KENNETH H. KIMMELL

SECTION 4, T32S, R3W, W.M.

APPLICATION 70120

PERMIT 50846


RECEIVED

FFB 28 1990

WATER RESOURCES DEPT.
SALMON, OREGON



1 INCH = 1320 FEET

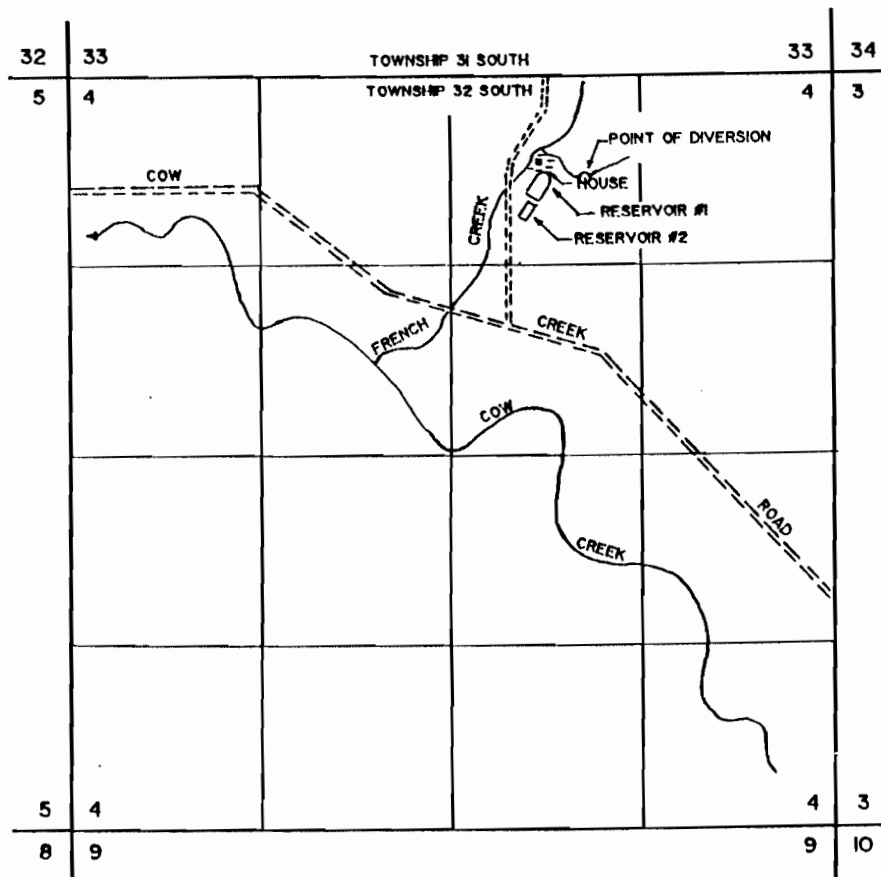

THE PURPOSE OF THIS MAP IS TO IDENTIFY THE LOCATION OF THE WATER RIGHT. IT IS NOT INTENDED TO PROVIDE INFORMATION RELATIVE TO THE LOCATION OF PROPERTY OWNERSHIP BOUNDARY LINES.

THE POINT OF DIVERSION IS LOCATED 700 FEET SOUTH AND 900 FEET EAST FROM THE NORTH 1/4 CORNER OF SECTION 4, BEING WITHIN THE NW 1/4 OF THE NE 1/4 OF SECTION 4, TOWNSHIP 32 SOUTH, RANGE 3 WEST, W.M.

