


T.4S.,R.1W.,W.M.

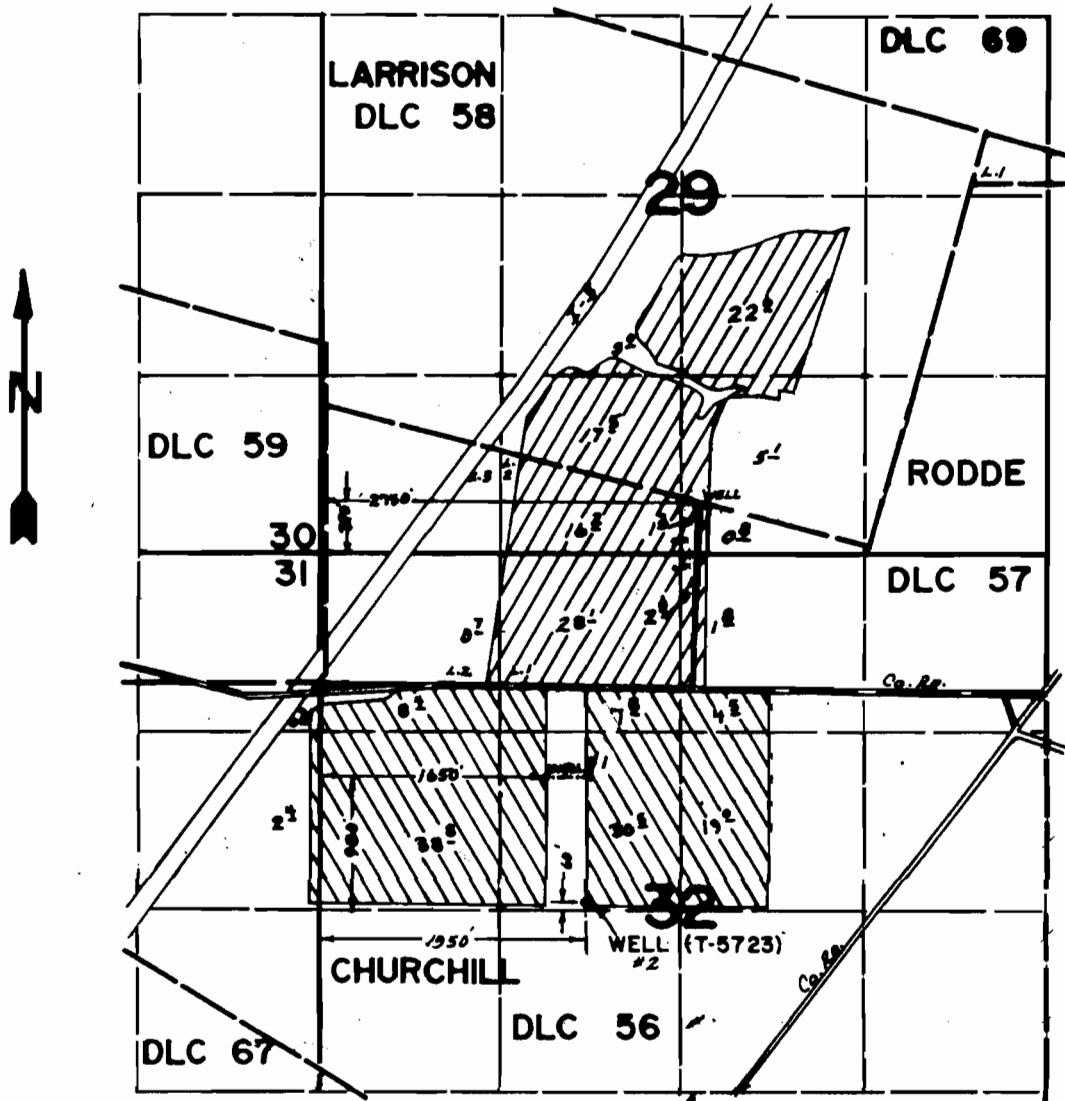

SCALE: 1" = 1320'

FINAL PROOF SURVEY UNDER

Transfer No. 5723

G-5806

G-5567

Application No. ~~G-5807~~ Permit No. ~~G-5568~~
IN NAME OF



TOM DEARMOND

Surveyed April 20, 1976, by L. T. P. H.
Mar. 20 1986 T.M. WARREN (T-5723)

T-5723 ADDED
4/3/86 BWS
DFN-ILL-48
DFN-ILL-50