


T.13S., R.14E., W.M.

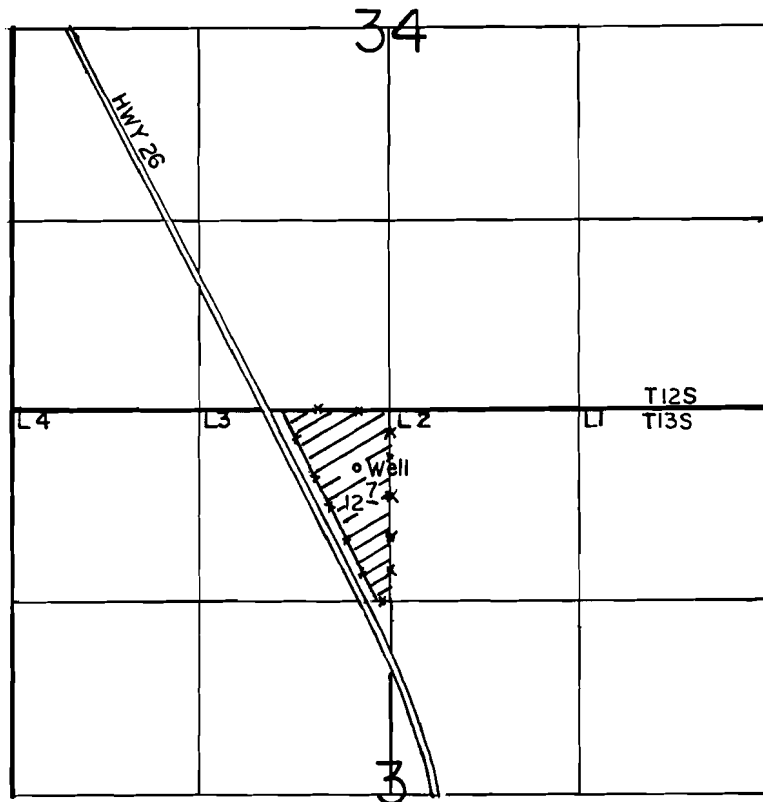

Well Loc 400'S & 220'W From The N1/4 Corner Of Section 3

SCALE: 1"=1320'

FINAL PROOF SURVEY UNDER

Application No. G-7922 Permit No. G-7313.....
IN NAME OF

.....ROBERT.....SELBY.....

Surveyed FEB...8... 1990., by B.W.BISHOP.....

Cont: 65348

RECEIVED
DATE 3-27-91
WATER MASTER DISTRICT #11
BY *DMJ*

G-7313