




T. 13 S., R. 14 E., W.M.

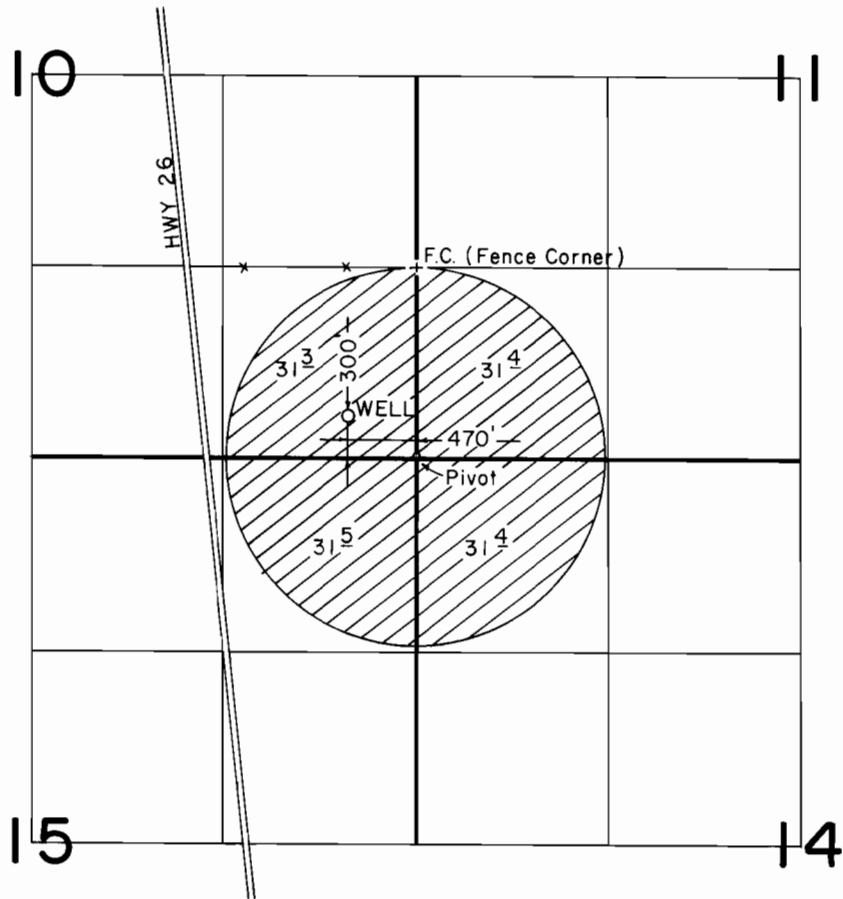

SCALE: 1" = 1320'

FINAL PROOF SURVEY
UNDER

Application No. G-8363 Permit No. G-7755....
IN NAME OF

.....**LARRY M. GILL**.....

Surveyed JAN. 17... 1990., by ..B. W. BISHOP....

3-22-90
PTS

gcL