




T. 9 S., R. 14 E., W.M.

SECTION 27

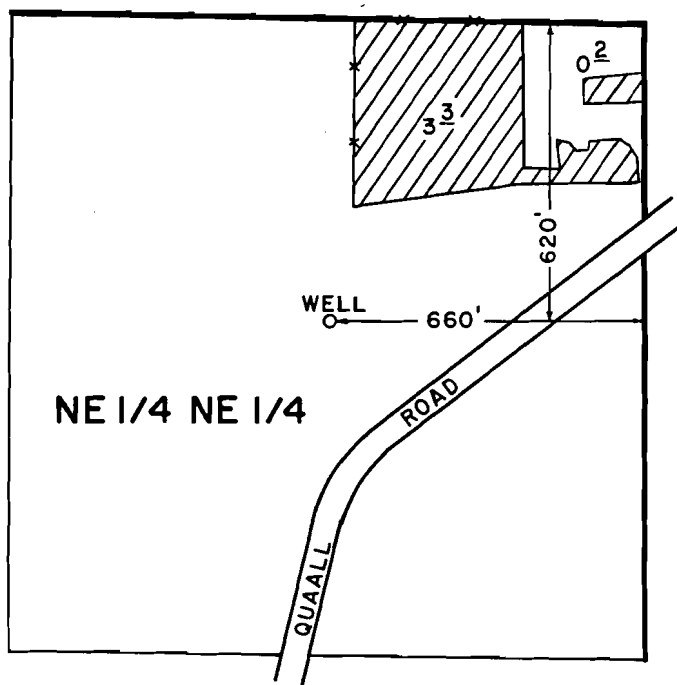

SCALE: 1" = 400'

FINAL PROOF SURVEY
UNDER

Application No. G-10463 Permit No. G-9399
IN NAME OF

WILLIAM E. RODGERS

Surveyed MARCH 20 1990, by B. W. BISHOP

RECEIVED

DATE

WATER MASTER DISTRICT #11

BY

Cert. 65354

4-19-90
PTS

for
G 9399