


T.38S.,R.9E.,W.M.

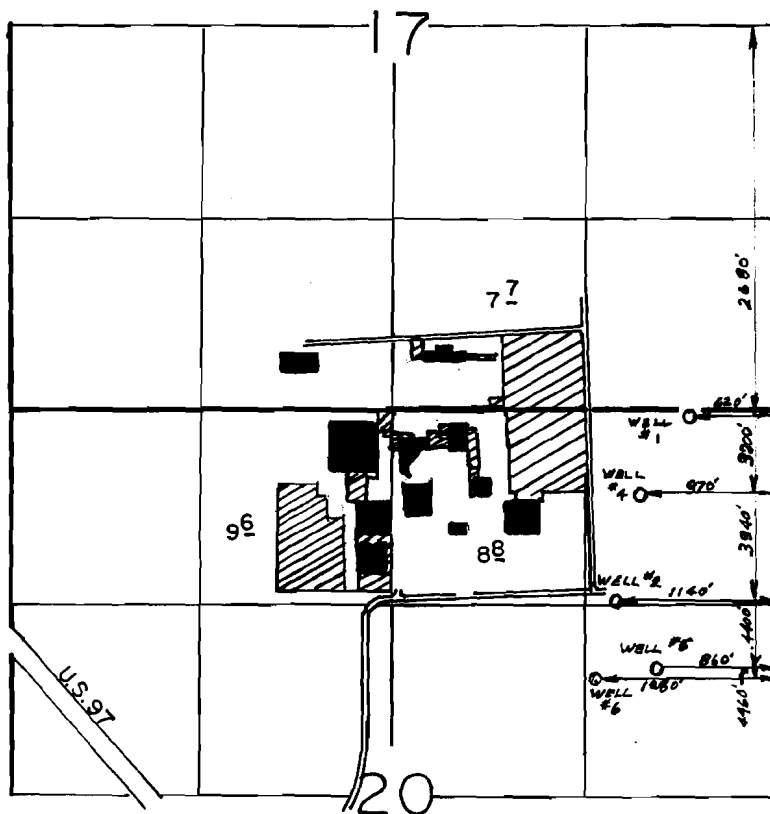

SCALE: 1" = 1320'

**FINAL PROOF SURVEY
UNDER**

Application No. G-10485 Permit No. G-10472....
IN NAME OF

..OREGON..INSTITUTE..of..TECHNOLOGY..

Surveyed APRIL 4.. 1980., by DEL SPARKS.....