


T. 27 S., R. 13 W., W. M.

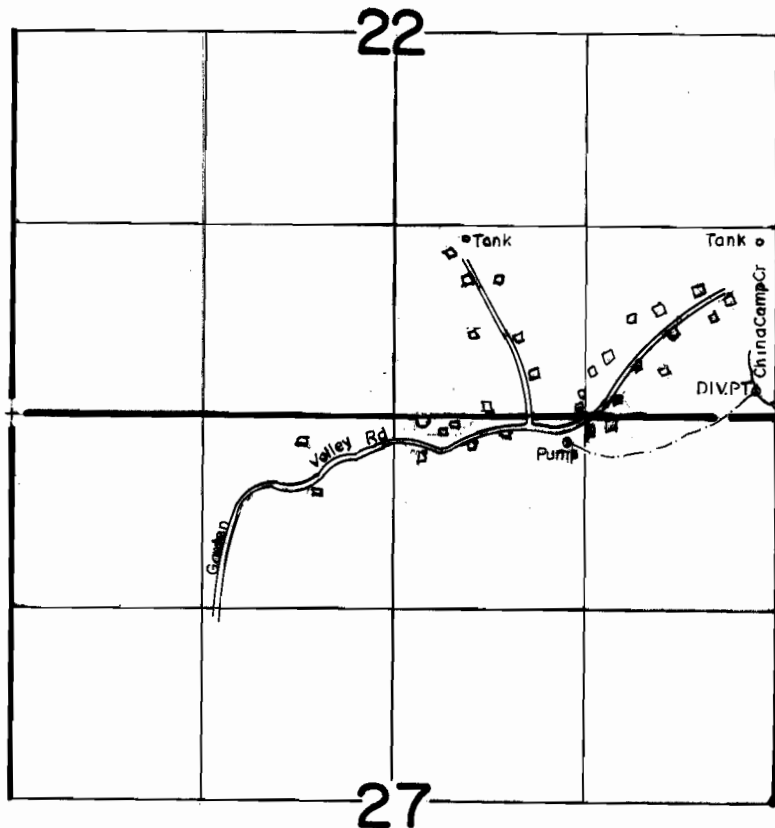

DIV PT LOC 180' N & 150' W FROM THE SE CORNER OF SECTION 22

Scale: 1" = 1320'

FINAL PROOF SURVEY UNDER

34008

26827

Application No. 41109... Permit No. 30651.....
IN NAME OF

GARDEN VALLEY WATER ASSOC.

Surveyed Sept. 17, 1988, by B.S. JAMES.....