


65362
RECEIVED
 JUN 25 1973
 STATE ENGINEER
 SALEM OREGON

Detail Map of Diversion Point
 Tanker loading
 S.E. 1/4, S.E. 1/4, Sec. 12, T. 28S., R. 7E., W.M.

Scale: 1/4 mile

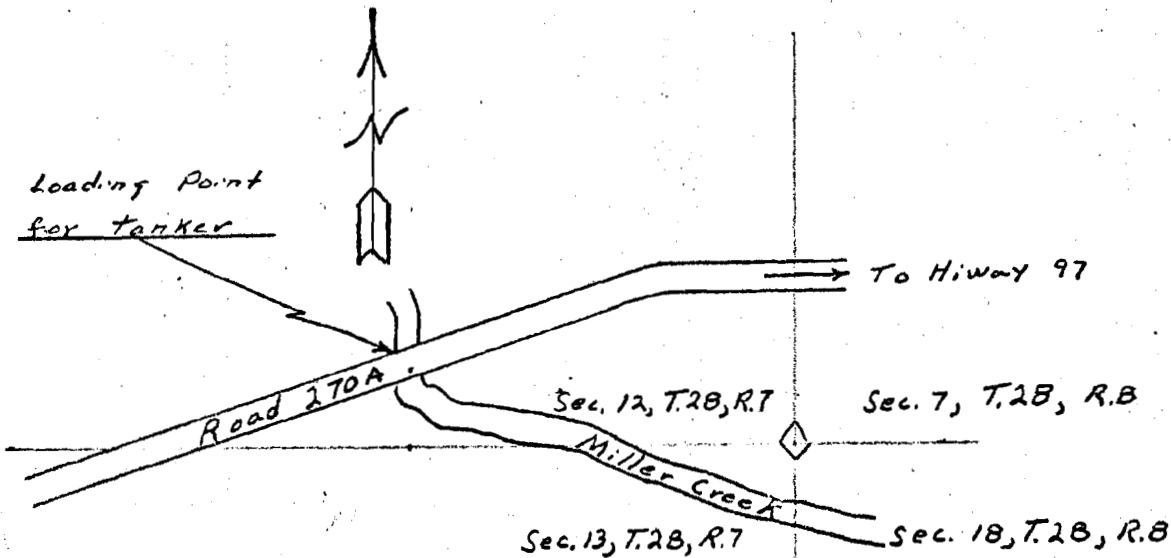

Road Maintenance

T	R
265	10E
275	10E & 7E
285	7-11E
295	7-11E

Application No. 50731
 Permit No. 38321

Williamson Co. Meas. C