


T35 R1E Section 23

1" = 400'

NE SW
SE SW

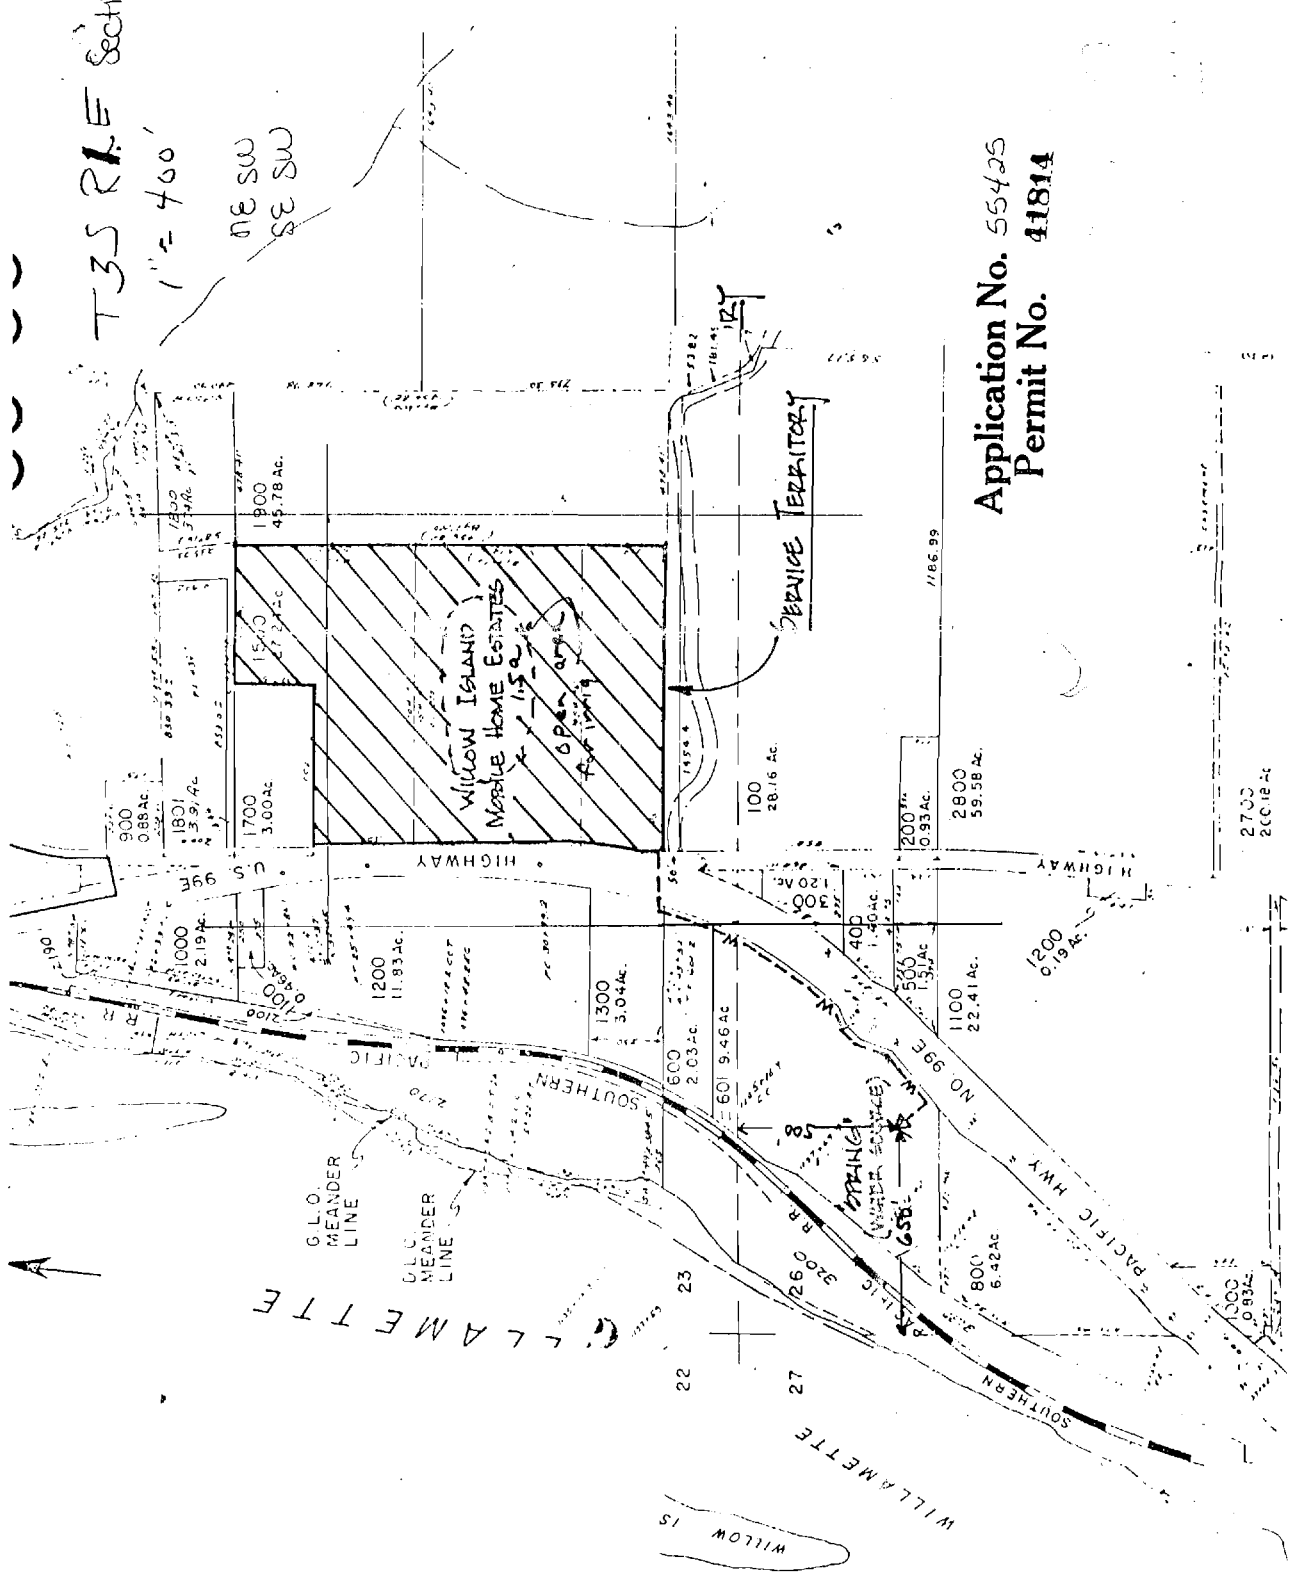

Application No. 55425
Permit No. 41814

2700
200.18 AC

1000
0.93 AC

800
6.42 AC

1100
22.41 AC

500
1.33 AC

400
1.40 AC

300
1.20 AC

200
0.93 AC

100
28.16 AC

1186.99

1594.4

161.45

161.45




