
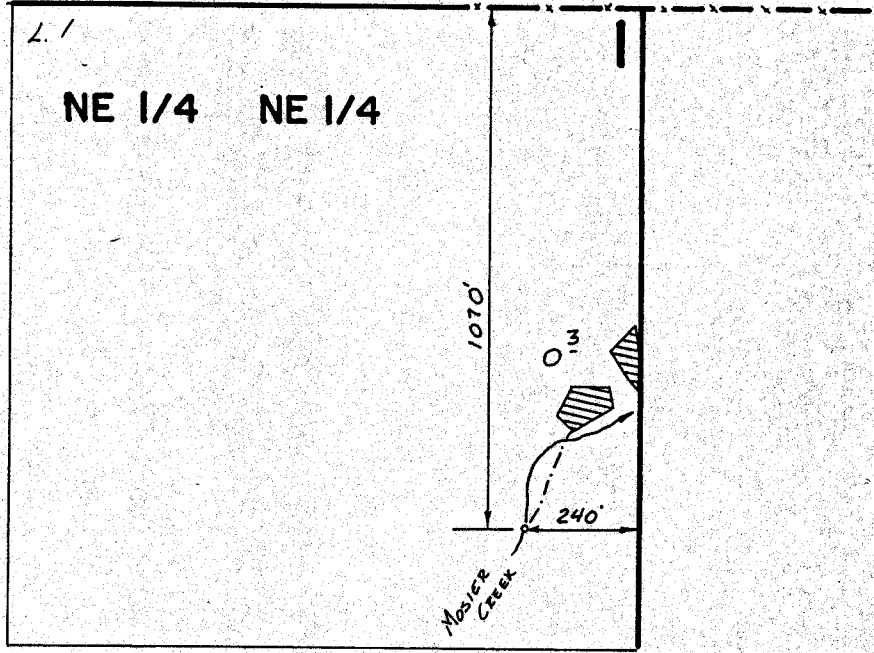


T. 1N., R. 11E., W.M.

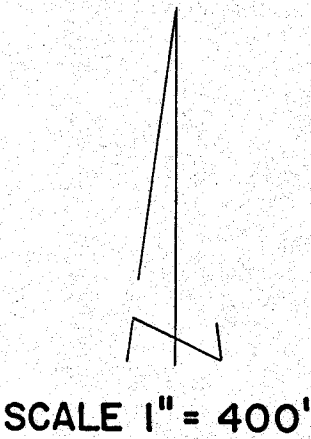

SECTION 1

FINAL PROOF SURVEY  
UNDER

Application No. **55964** Permit No. **42607**  
IN NAME OF

**ROBERT L., ROBERTA J., & DOUGLAS L. MARTIN**

Surveyed 4-17 1989, by V.L. Church