


T.9S., R.39E., W.M.

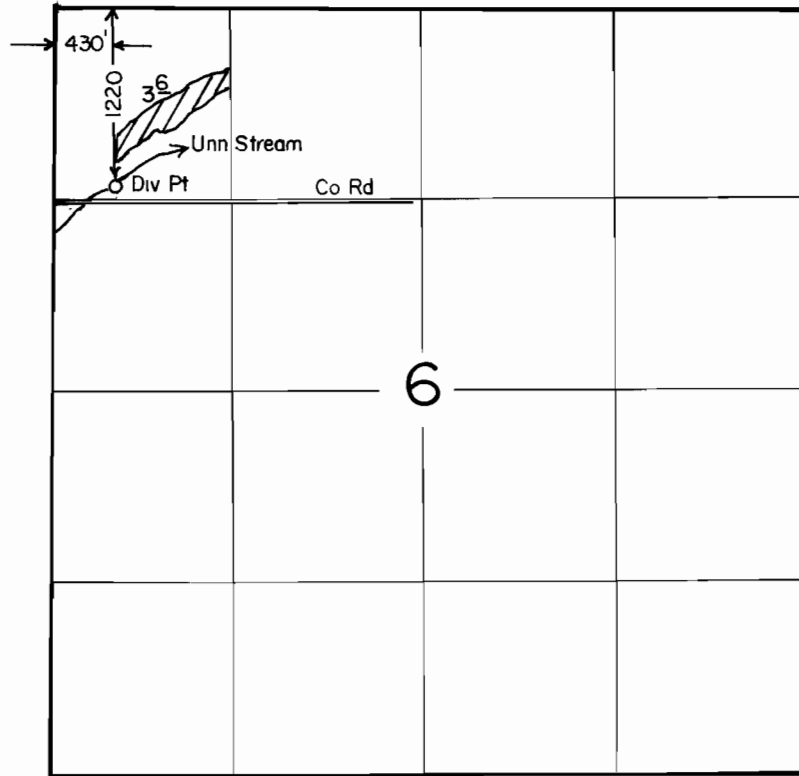

SCALE:1"=1320'

FINAL PROOF SURVEY
UNDER

Application No. 55985.... Permit No. 42262.....
IN NAME OF

SARA L. LIDDELL

Surveyed NOV. 2.... 1989., by V.L. CHURCH.....