


T. 9 S., R. 14 E., W.M.

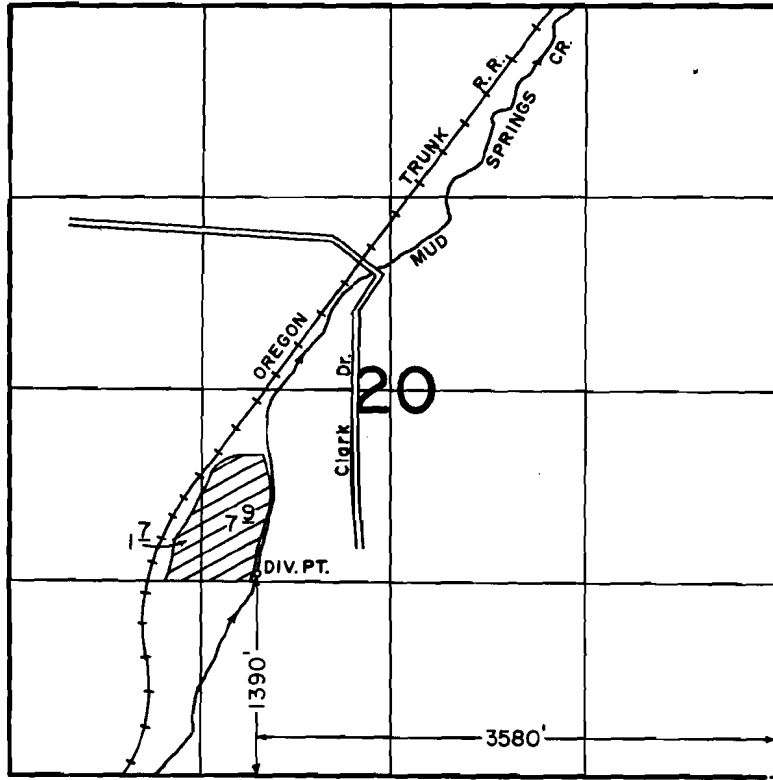

SCALE: 1" = 1320'

**FINAL PROOF SURVEY**  
UNDER

Application No. 56076. Permit No. 43003  
IN NAME OF

*Cert. 65367*

ROBERT SHORT

Surveyed OCT. 24, 1989, by B. W. BISHOP

RECEIVED

DATE

WATER MASTER DISTRICT #11

BY

12-27-89  
41031-179-94 A

*for*  
43003