




T. 33 S., R. 1 E., W.M.

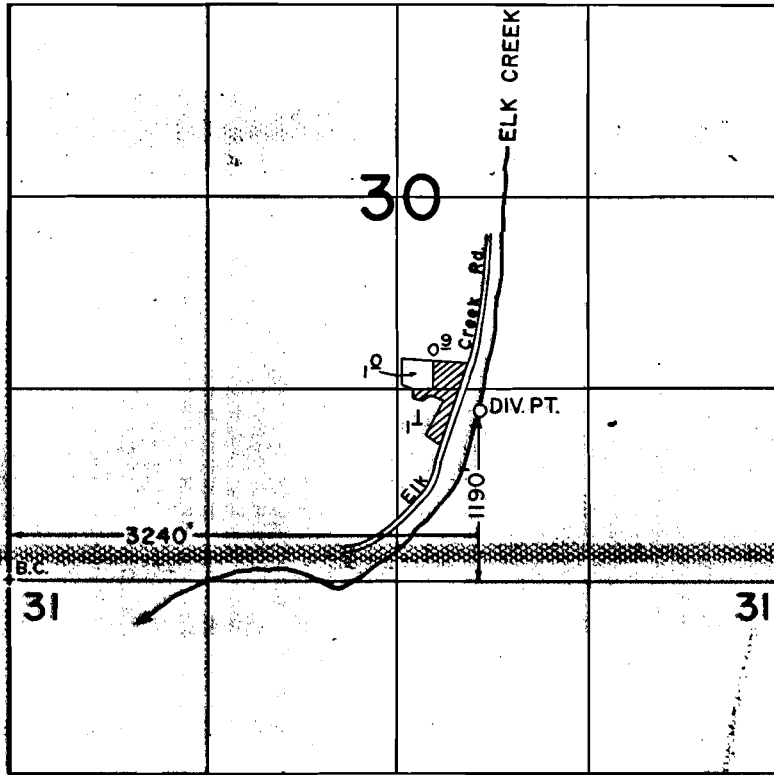

SCALE: 1" = 1320'

FINAL PROOF SURVEY
UNDER

Application No. 56135.. Permit No. 42373.....
IN NAME OF

EAGLE POINT SCHOOL DISTRICT NO. 9

Surveyed JUNE 27 1989., by B. S. JAMES.....