




T. 37 S., R. 14 W., W.M.

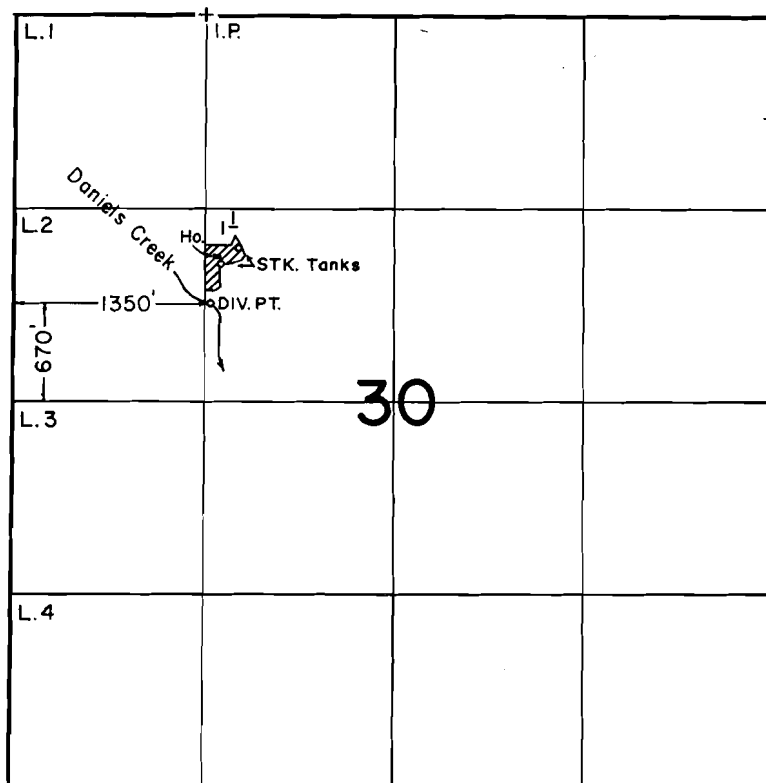

SCALE: 1" = 1320'

FINAL PROOF SURVEY
UNDER

Application No. 56649. Permit No. 42553.....
IN NAME OF

JAMES R. HANSON.....

Surveyed JULY 28 1989, by B.S. JAMES.....

JS