



T.8S. & T.9S., R.40E., W.M.

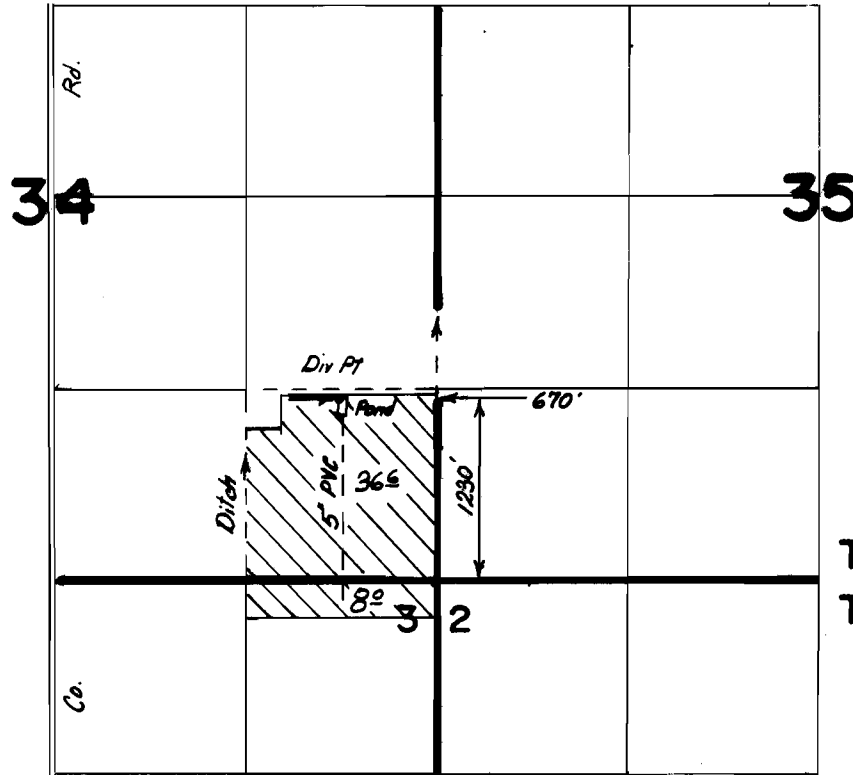

FINAL PROOF SURVEY UNDER

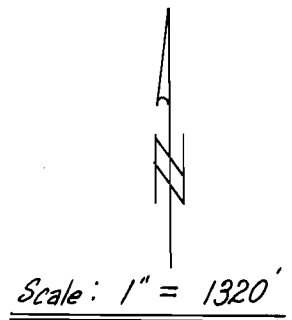

Application No. **56846** Permit No. **42654**
IN NAME OF

WARREN I., KYLE D., & ARLEN DRIGGERS

Surveyed **5-23** 19**89**, by **Kenn Kemp**