




T. 34 S., R. 5 W., W.M.

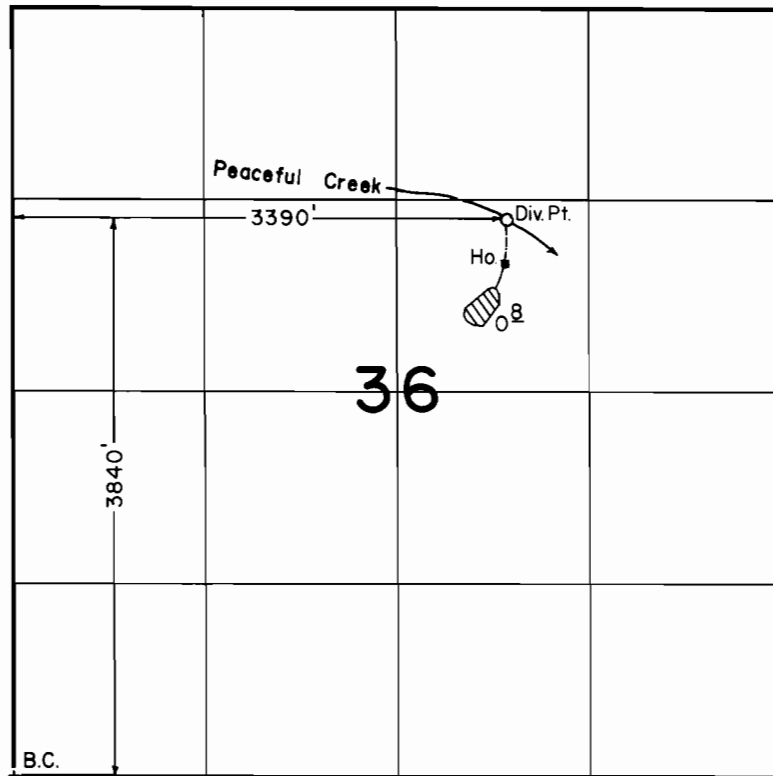

SCALE: 1" = 1320'

**FINAL PROOF SURVEY**  
UNDER

Application No. 57742. Permit No. 43593.....  
IN NAME OF

PHILIP KING

Surveyed JUNE 13, 1989, by B. S. JAMES.....

12-18-89

41033-179-118 R