


T. 32S., R. 14W., W.M.

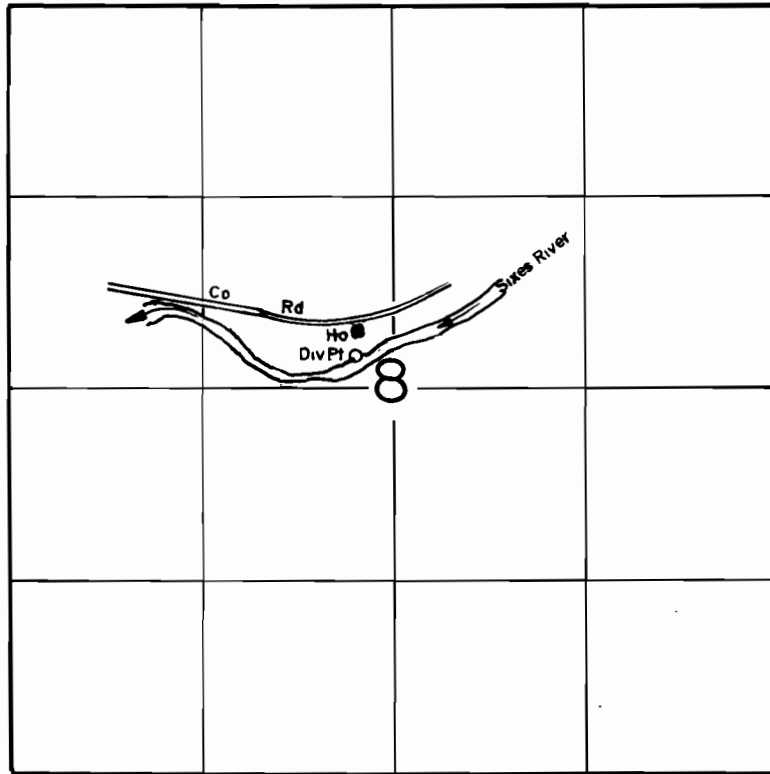

Div Pt Located 220' N & 250' W From The Center 1/4 Corner Of Sec 8

SCALE: 1" = 1320'

FINAL PROOF SURVEY
UNDER

Application No. 57828... Permit No. 43559.....
IN NAME OF

.....**DEBOYD L. SMITH**.....

Surveyed JULY 29... 1989., by B.S. JAMES.....