



Copy


RECEIVED
JAN 4 1982
WATER RESOURCES DEPT.
SALEM, OREGON

R-41-EWM.

RECEIVED

NOV 10 1983
WATER RESOURCES DEPT.
SALEM, OREGON

To Burnt River

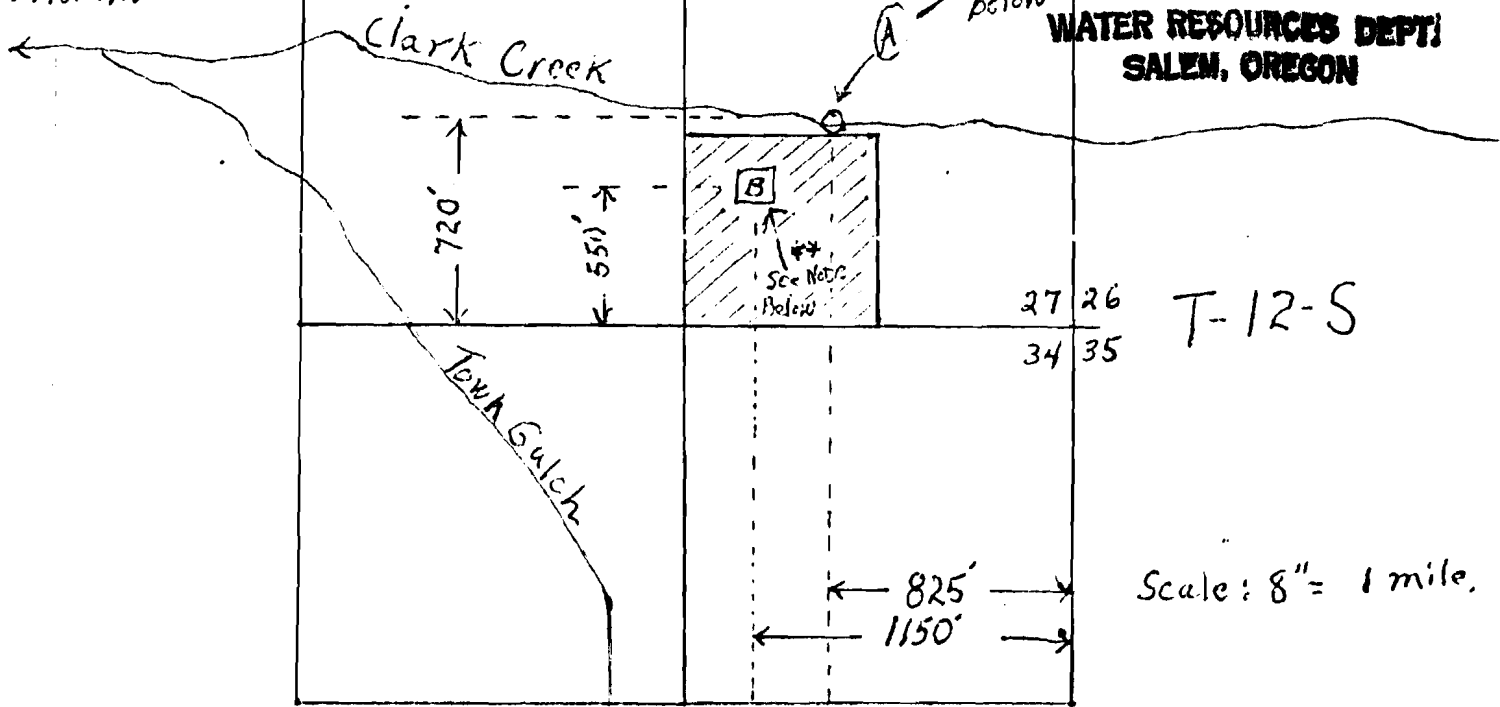

* (A) Proposed Point of Diversion pond with Pumps,
2-Cu. Ft. per Sec. (720' N & 825' W
from SE Cor. Sect. 27.)

** (B) Water Storage plus use of Water from Hoses
(550' N & 1150' W
from SE Cor. Sect. 27.)

RECEIVED
OCT 7 1982
WATER RESOURCES DEPT.
SALEM, OREGON

Application No. 63197
Permit No. 47122

James B. Marshall