


T.10S., R.2W., W. M.

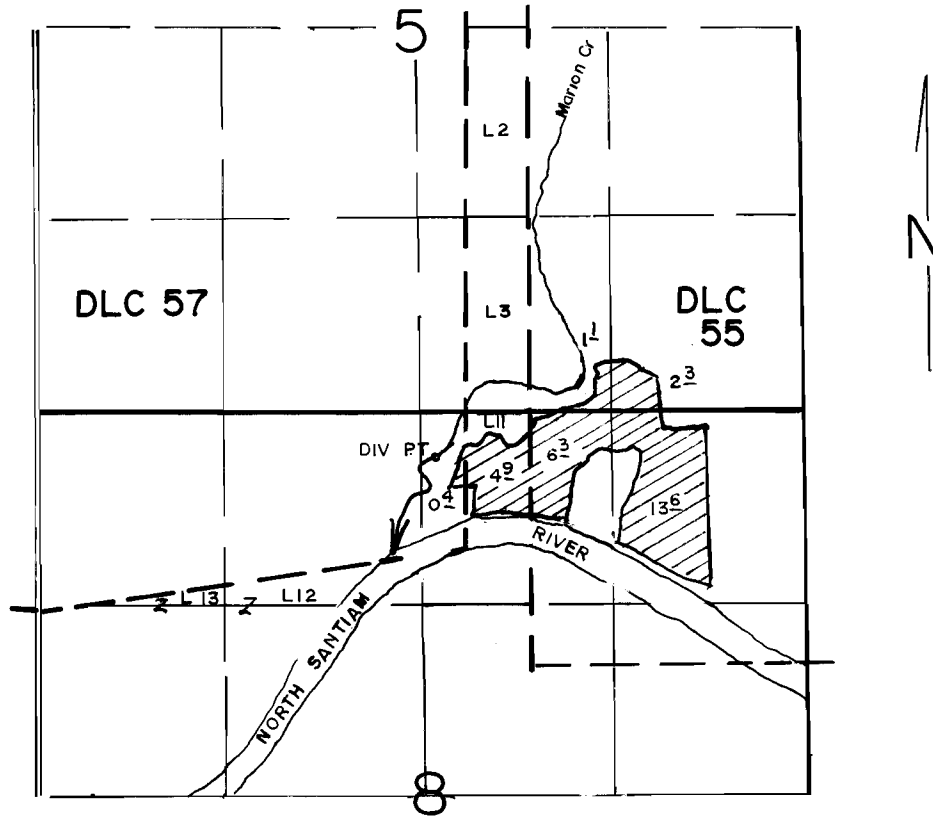

Div Pt Located 300'S & 90'E From 1/4 Corner Of Section 5

SCALE: 1" = 1320'

FINAL PROOF SURVEY
UNDER

Application No. 63511... Permit No. 46823....
IN NAME OF

..... FLOYD L BAILEY JR.

Surveyed JULY 6, 1990, by T.M. WARREN...