


# T. 34 S., R. 7 & 7 1/2 E., W.M.

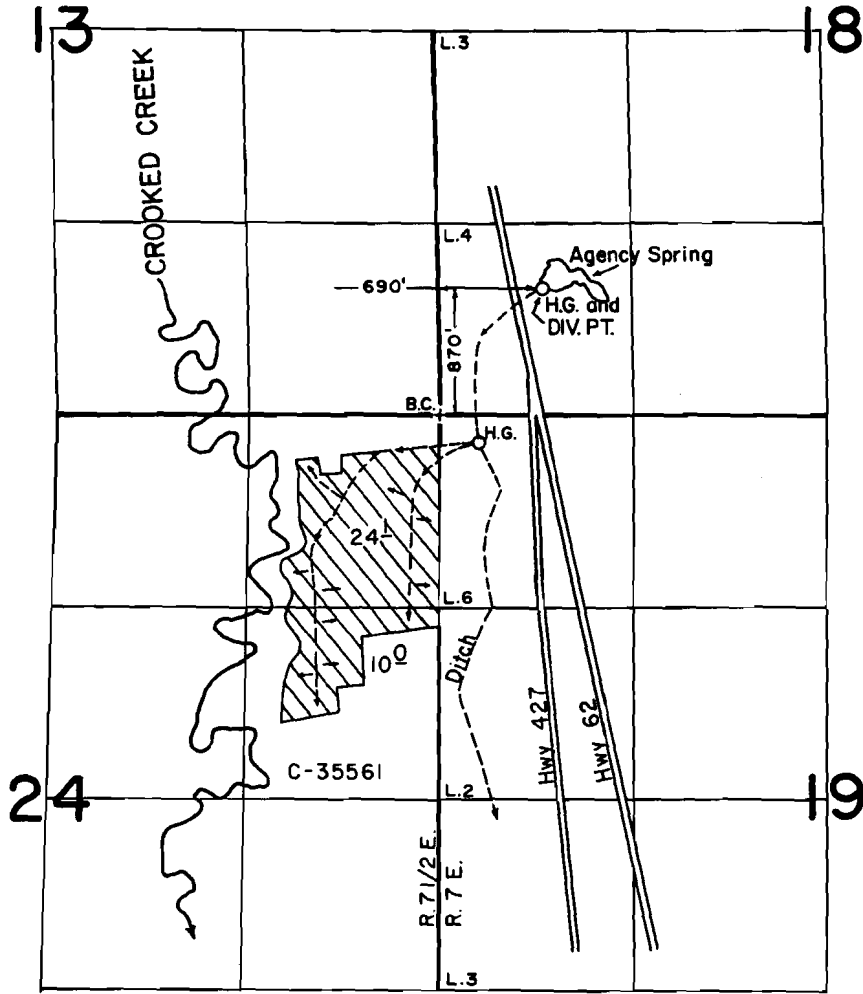

*Crooked Creek & Misc*

SCALE: 1" = 1320'

## FINAL PROOF SURVEY UNDER

Application No. 65024.. Permit No. 47729.....  
IN NAME OF

KURT THOMAS

Surveyed SEPT. 14 1989, by R. W. BISHOP....