


T.37S., R.2E., W. M.

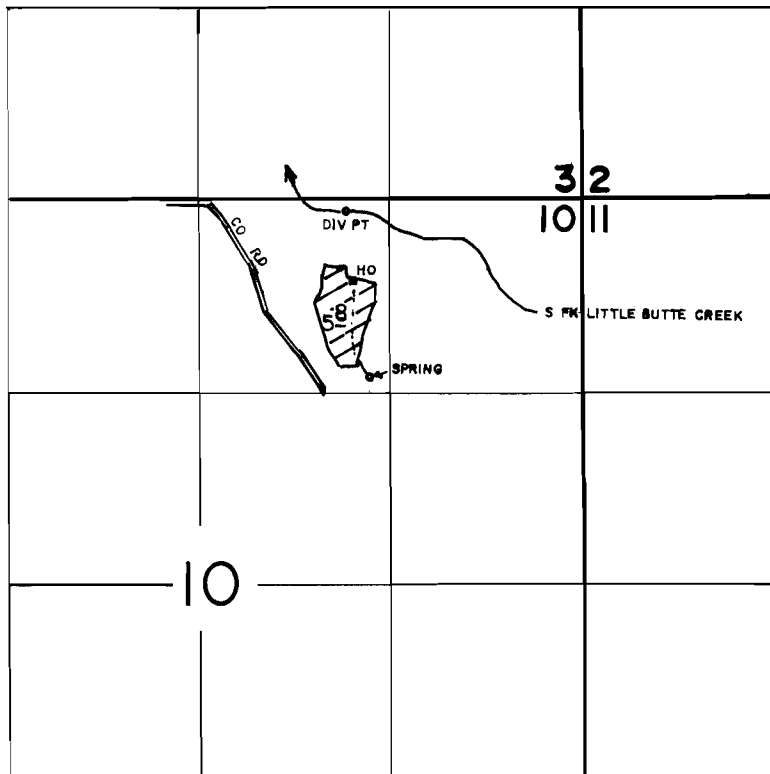

Div Pt Loc. 100'S & 1020'E - Spring Loc. 1250'S & 1170'E Both From The N 1/4 Corner Of Section 10

SCALE: 1" = 1320'

FINAL PROOF SURVEY UNDER

62812

46254

Application No. 65036.... Permit No. 47532.....

IN NAME OF

..... **LUCILLE KOPANSKI**

Surveyed JULY 13..... 1989., by B.S. JAMES.....