


T.12 & 13 S., R. 9 E., W.M.

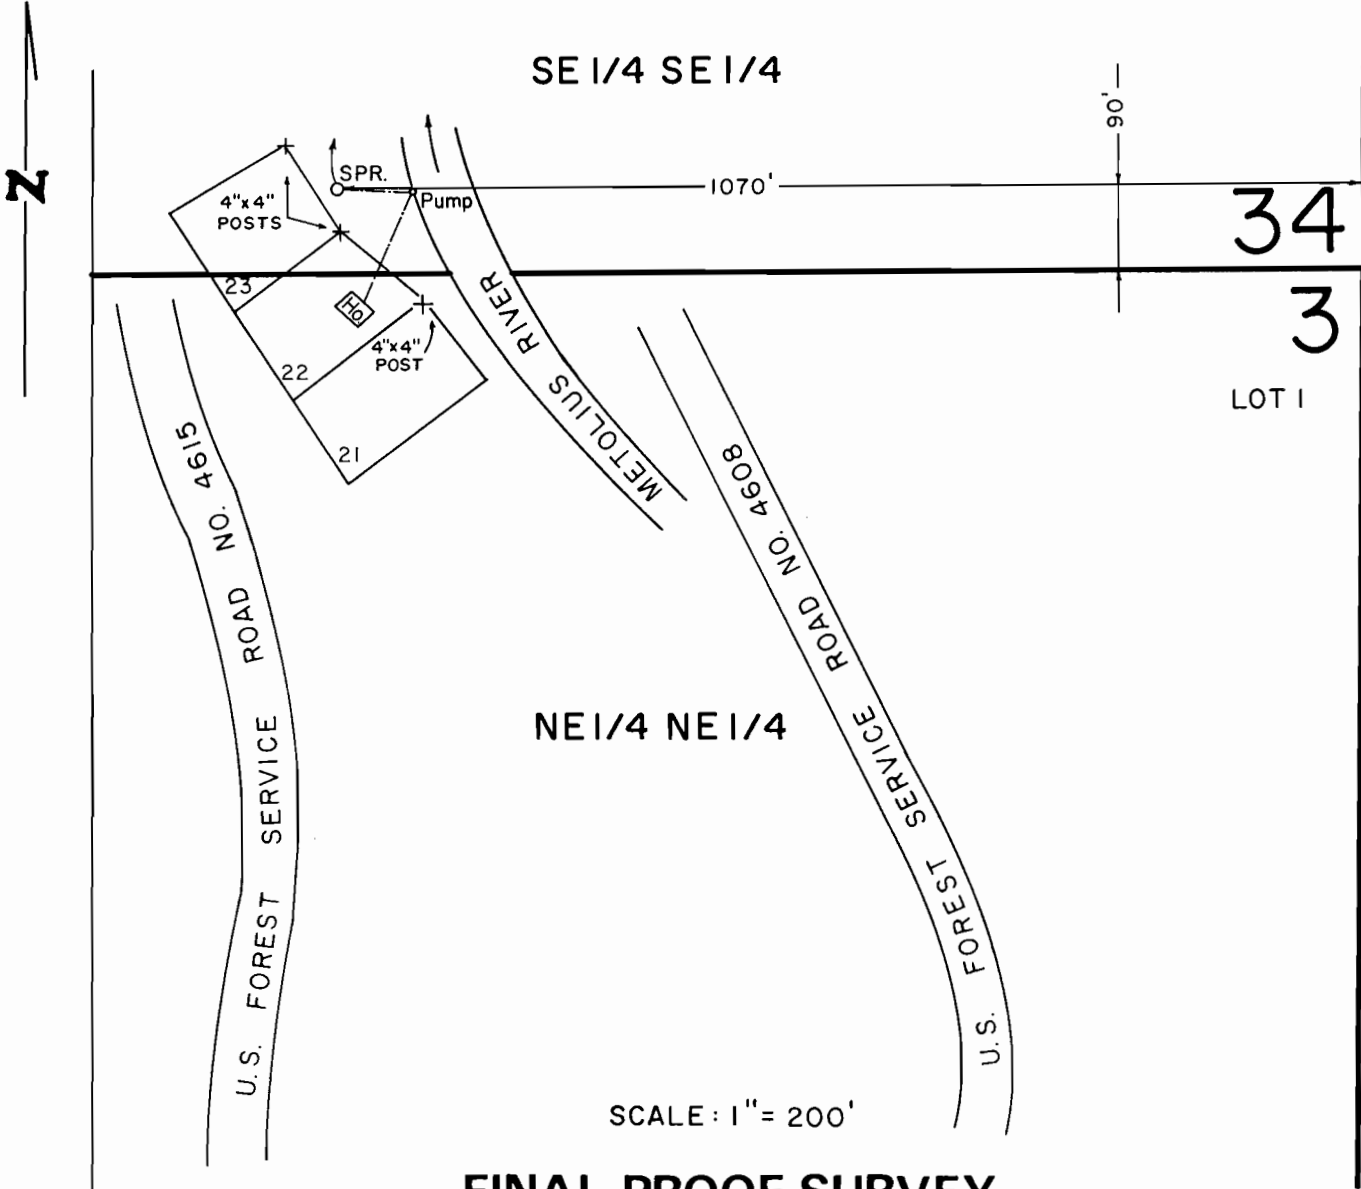

FINAL PROOF SURVEY UNDER

Application No. ~~6.5.4.7.4.~~ Permit No. ~~.4.7.9.2.8.~~....
IN NAME OF

.....MARIE B. TOOZE.....

Surveyed JUNE 30 1989, by B. W. BISHOP.....