


T.37S., R.14W., WM.

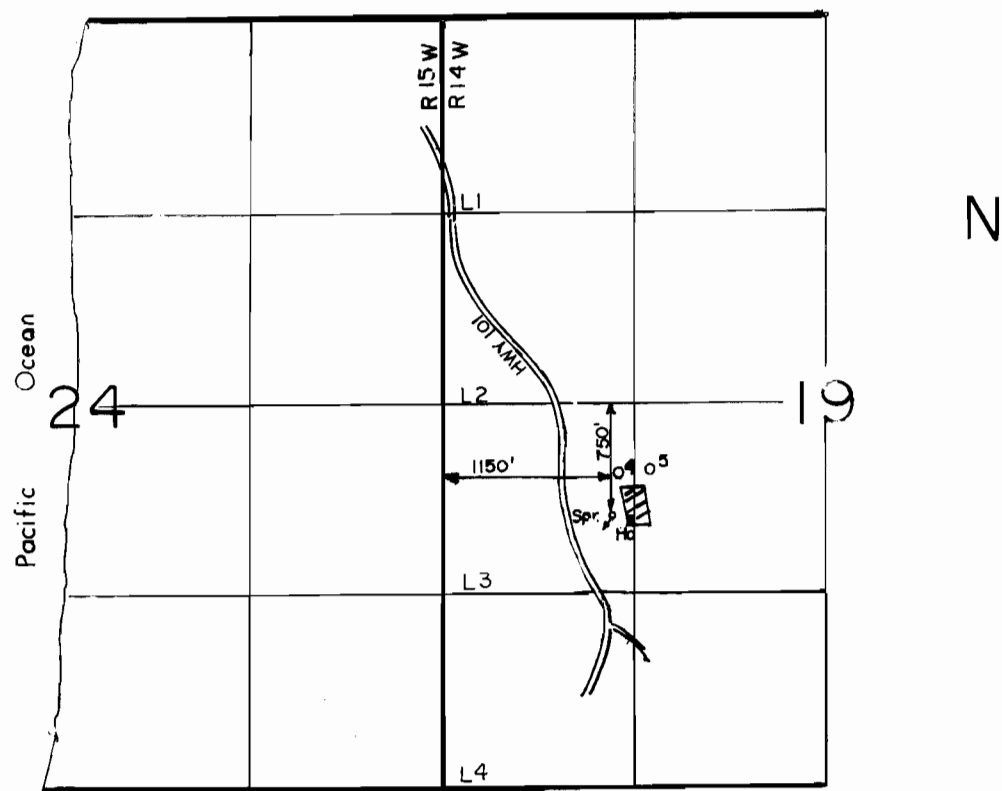

SCALE: 1"= 1320'

FINAL PROOF SURVEY
UNDER

Application No. 65517... Permit No. 48231.....
IN NAME OF

.....DONALD B THOMAS.....

Surveyed JUNE 4... 1990., by B.S.JAMES.....