


T. 12 S., R. 11 W., W. M.

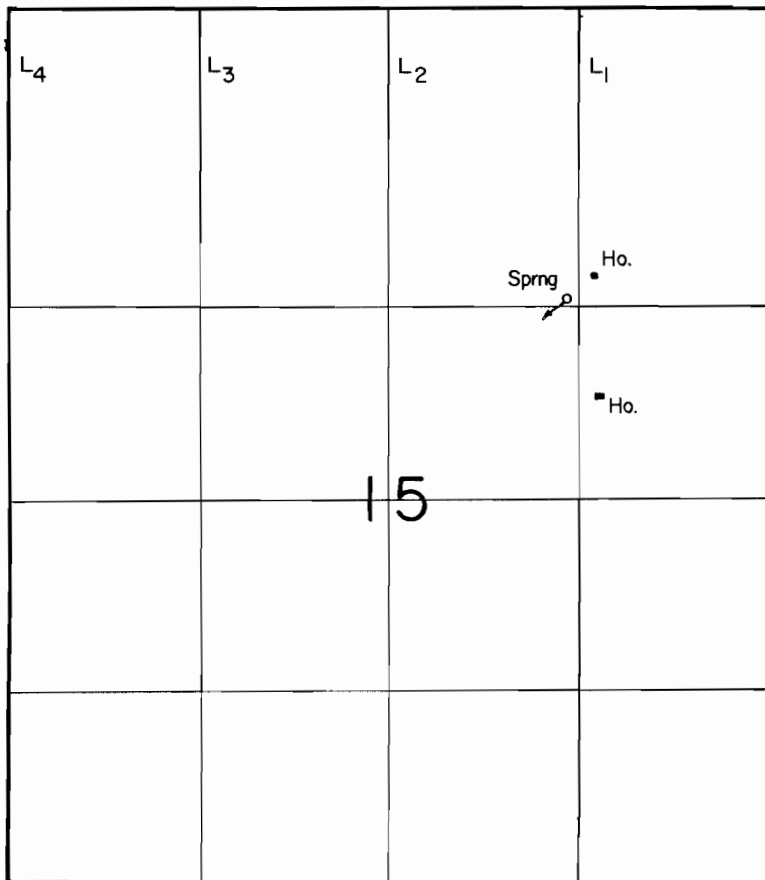

Spring Loc. : 1360' N. & 1240' E. from C-1/4 Cor. Sec. 15.

Scale : 1" = 1320'

FINAL PROOF SURVEY

UNDER

Application No. 66935.. Permit No. 48432.....
IN NAME OF

M. F. BEAL, D. L. METZ & C. M. KERRINCKX

Surveyed Sept. 21, 1989, by R. KLASSEN