


T.2S., R.2E., W.M.

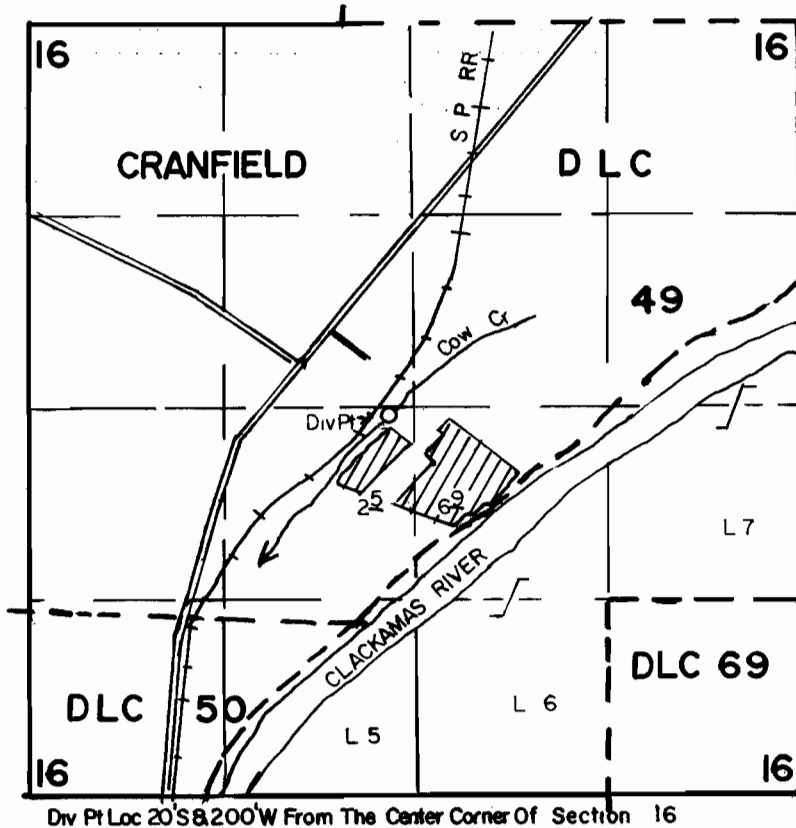

SCALE: 1" = 1320'

FINAL PROOF SURVEY
UNDER

Application No. 67686... Permit No. 48259.....
IN NAME OF

.....RALPH W. CHANEY.....

Surveyed .AUG..14. 1989., by R.W. KLASSEN.....