


Application No. 61986
 Permit No. 48457

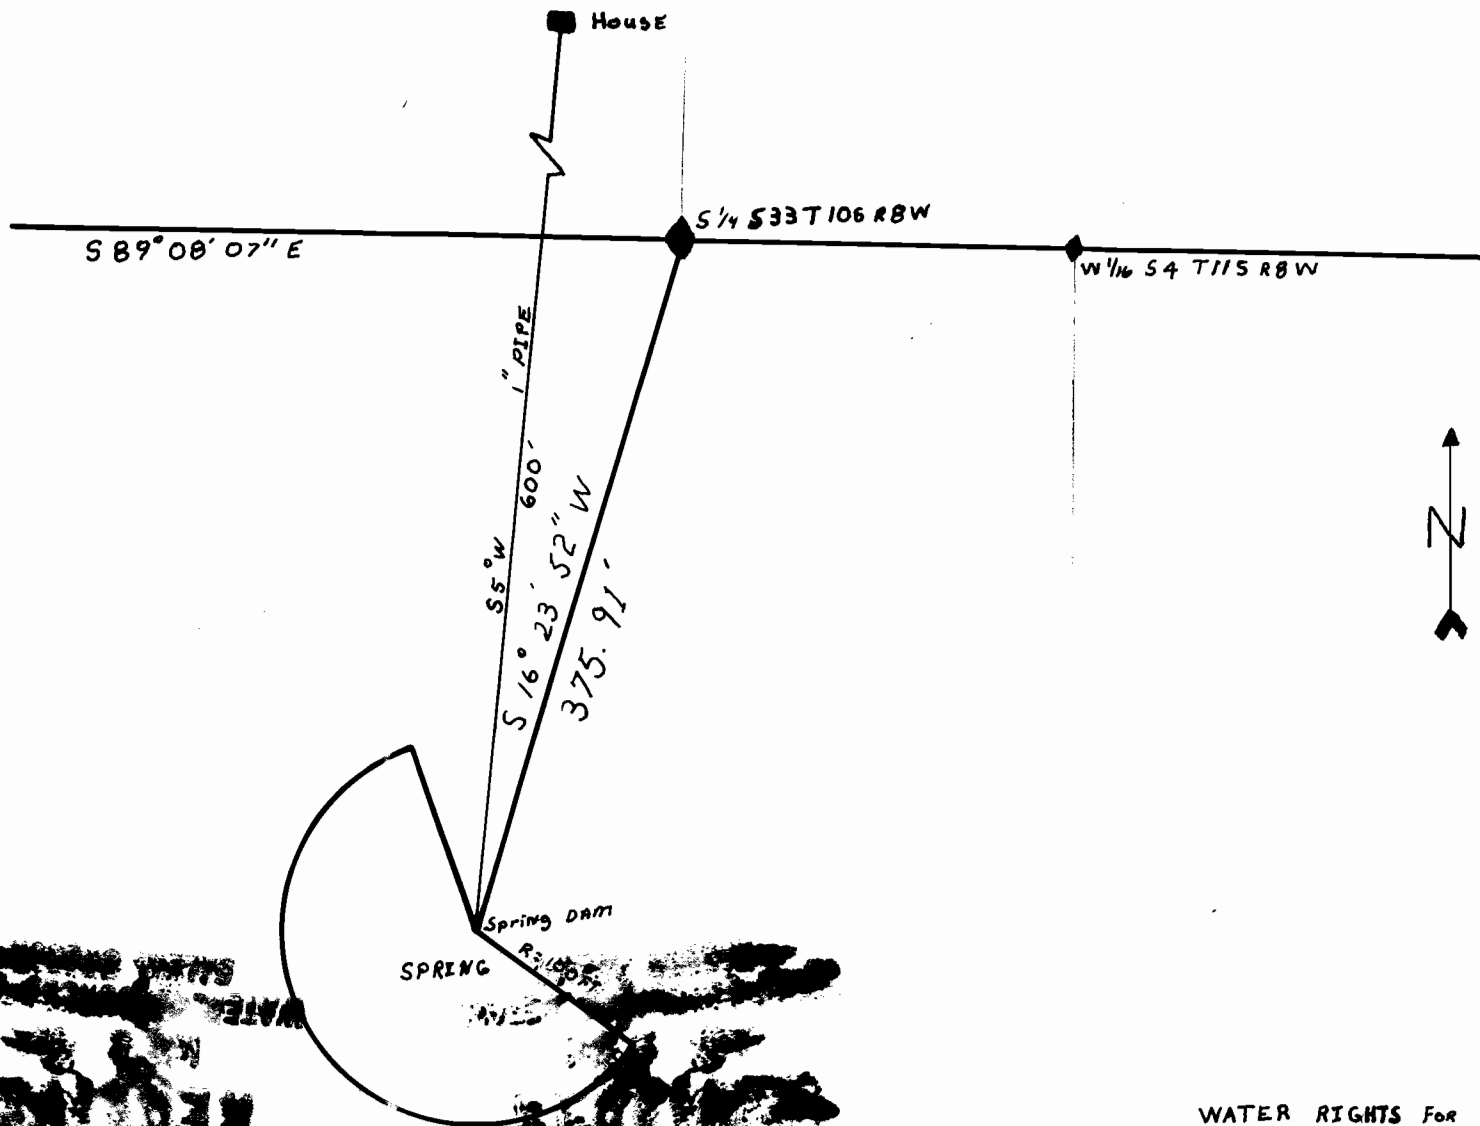

WATER RIGHTS For N.C. EDWARDS

Scale: 1 inch = 100 feet

Drawn by Tom Edwards

RECEIVED
 DEC 5 1983
 WATER RESOURCES DEPT.
 SALEM, OREGON

RECEIVED
 FEB 9 1984
 WATER RESOURCES DEPT.
 SALEM, OREGON