


T. 36S., R. 2E., W. M.
S.W. 1/4 SECTION 33

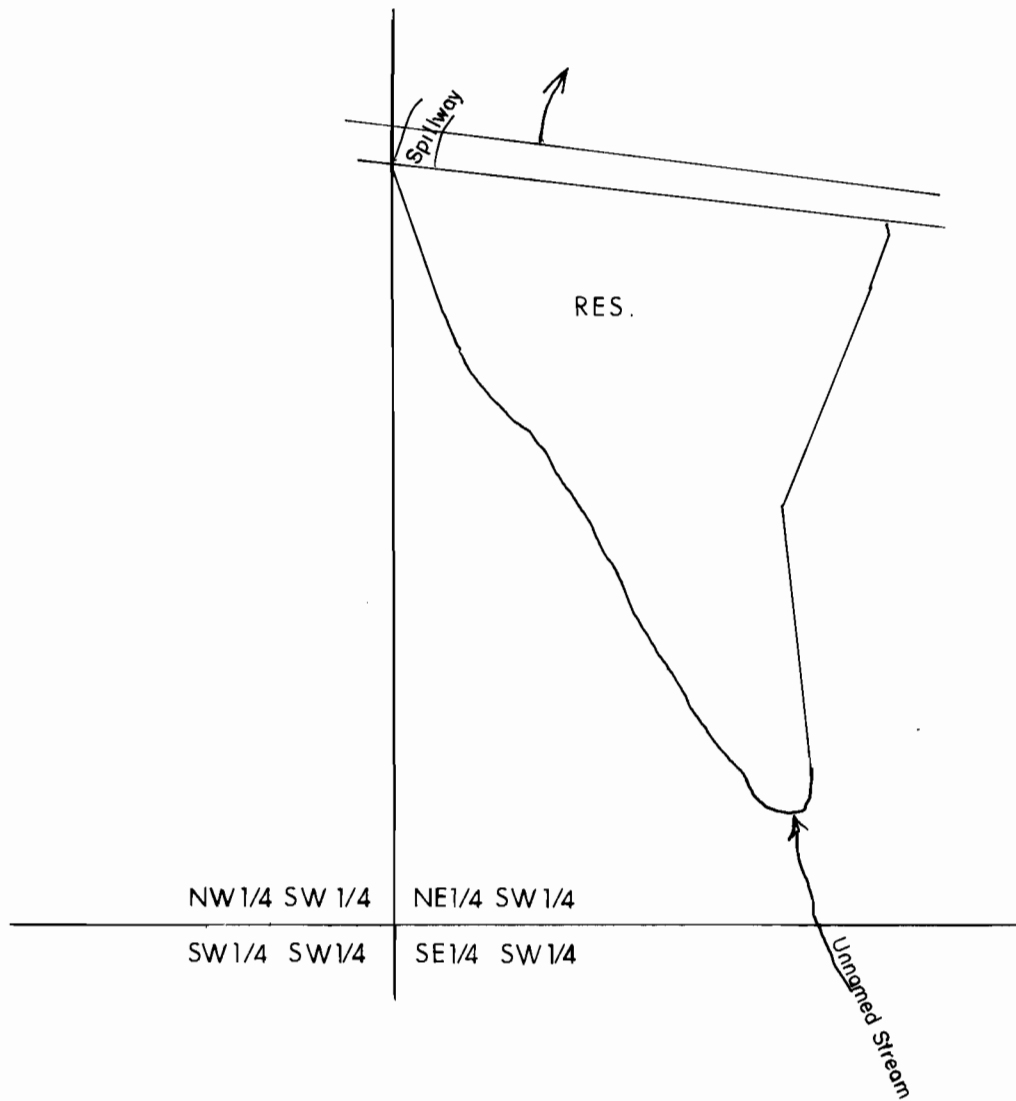

SCALE: 1" = 100'

FINAL PROOF SURVEY
UNDER

Application No. R-6.8593.. Permit No. R-10601.....
IN NAME OF

.....**DAN R. SHUGART**.....

Surveyed JULY 18, 1989, by B.S. JAMES.....