

UN

T. 18 S.


T.17S. & 18S., R.17E., W.M.

FINAL PROOF SURVEY
UNDER

Application No. 68602. Permit No. 49619
IN NAME OF

RICHARD NELSEN

Surveyed JAN. 1, 1990, by B.W. BISHOP

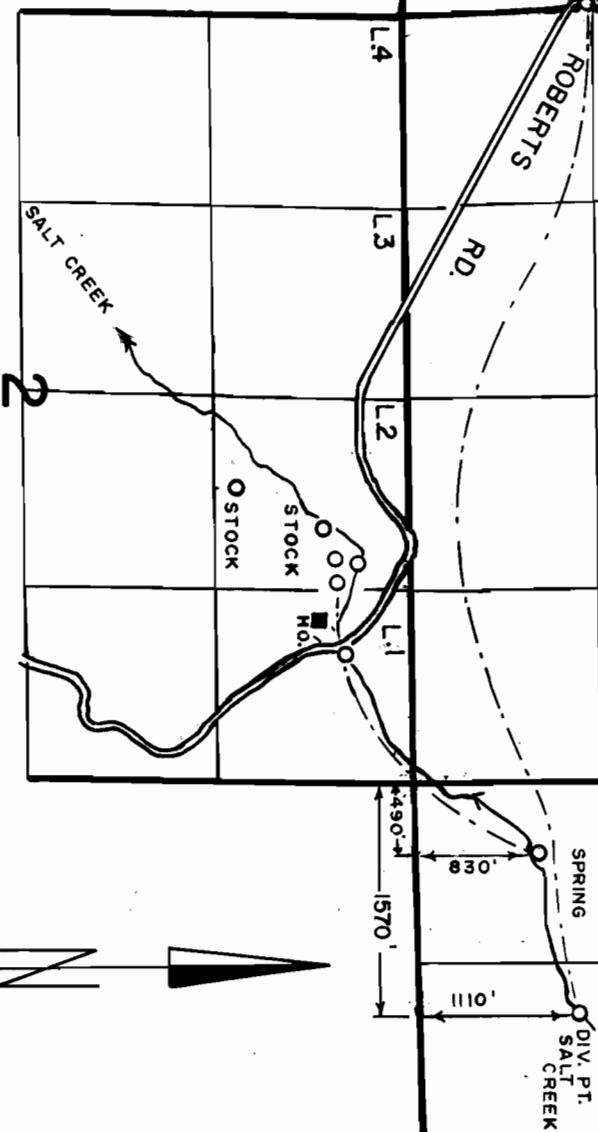

1"=1320'

4-25-90 DSM

41013-180-104A