

11 NE 1/4 OF NORTH
12 NW 1/4 OF NORTH

TOWNSHIP 38S, RANGE ~~11E~~ W.M.

49648
RECEIVED


DEC 12 1985 65401

WATER RESOURCES DEPT
SALEM, OREGON

RECEIVED

FEB 28 1986

WATER RESOURCES DEPT
SALEM, OREGON

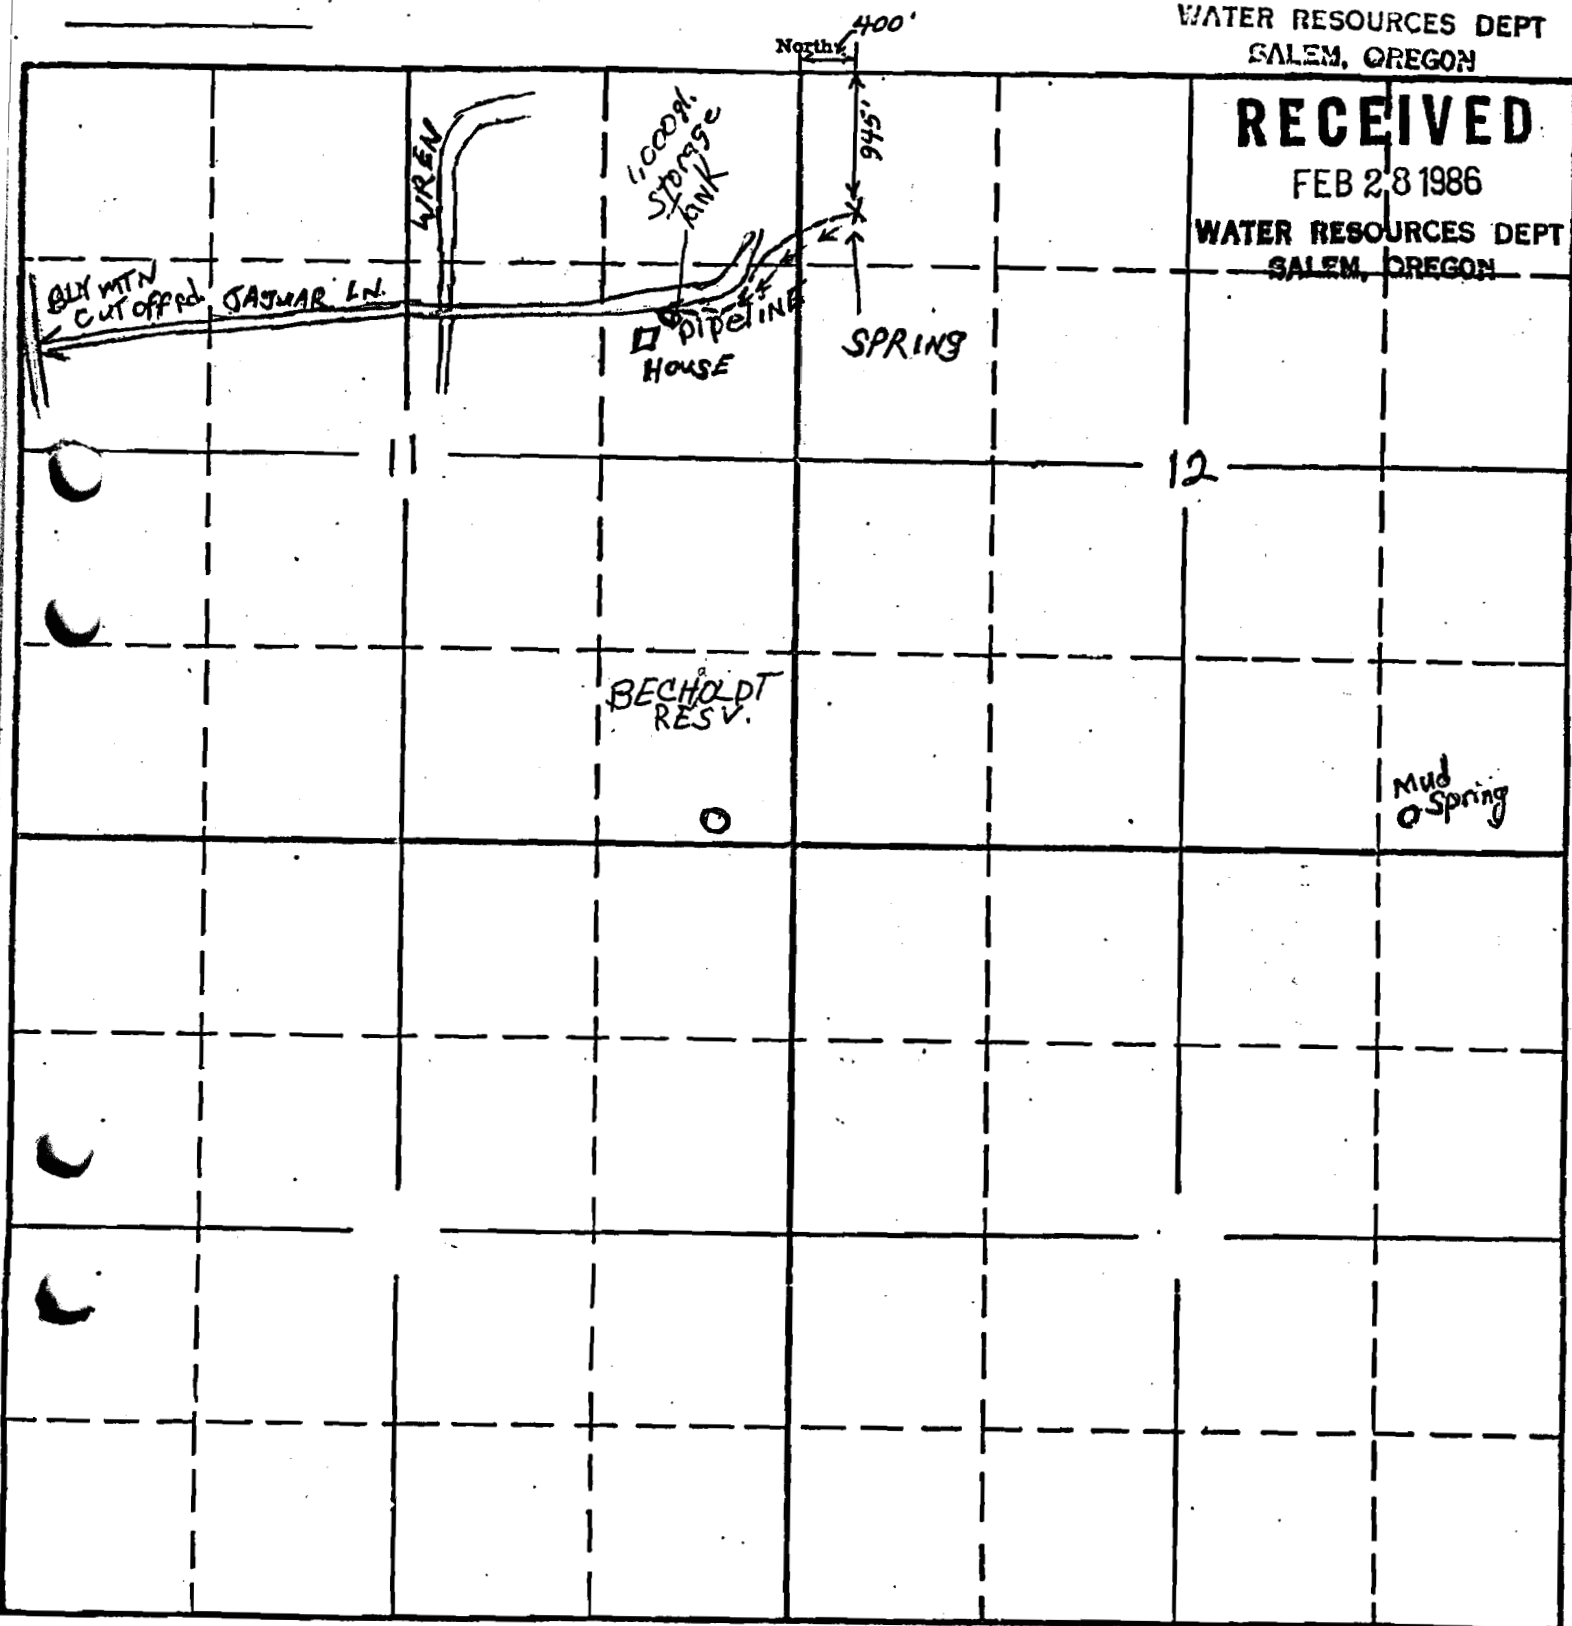

RECEIVED APPLICATION No. 68632

JAN 28 1986

PERMIT No.

WATER RESOURCES DEPT
SALEM, OREGON

49648