


T. 4 S., R. 2 E., W. M.

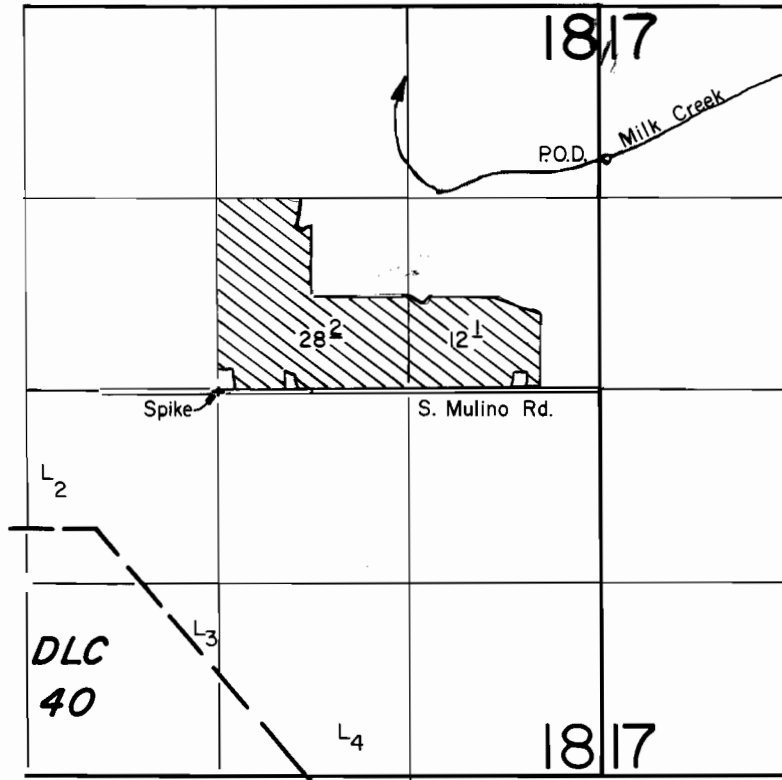

P.O.D. Loc.: 1577' N. & 50' E. from E. 1/4 Cor. Sec. 18.

Scale: 1" = 1320'

FINAL PROOF SURVEY UNDER

Application No. 68648 Permit No. 49655
IN NAME OF

WALTER A. HANSEN

Surveyed AUG. 11, 1989, by R. KLASSEN